

PONTOTOC  
A34  
6-29-72

MISSISSIPPI  
BOARD OF WATER COMMISSIONERS  
416 North State Street  
Jackson, Mississippi 39201

85000  
4750  
Total \$ 89750

WATER WELL DRILLERS LOG

6-29-72 date well completed 1972 J.T. Medlin firm name Pontotoc county well located

LANDOWNER:	description of formations encountered	from	to
Bartley Motomony Humboldt (mailing address)			

WELL LOCATION:  
sec. 26 T. 8 N. R. 1 E  
2 miles W of Humboldt  
(distance) (direction) (nearest town)

WELL PURPOSE:  
(home, irrigation, municipal, industrial)

- WELL COMPLETION DATA:
- (1) diameter (inches) 4
  - (2) total depth (feet) 480
  - (3) static water level (feet) 80 below top of ground.
  - (4) casing P, 140 (material), (depth)  
(size) If telescope see back.
  - (5) screen (length) (depth to top)  
(size) (material)
  - (6) pump 1/2 (HP), 5 (yield gpm)  
(type power)
  - (7) electric log (yes or no)  
(organization running log)
  - (8) how well bottom plugged


DRILLERS REMARKS:

NOV. 18 1972

MISS. BD. OF WATER COMMISSIONERS

If well telescopes please sketch and show depths.

GROUND LEVEL

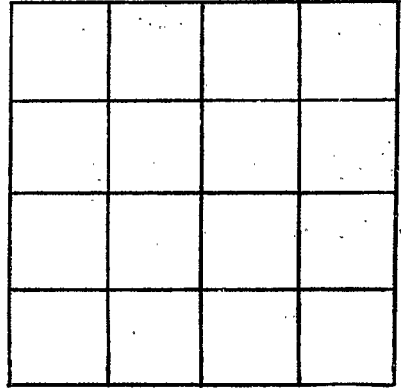

SECTION \_\_\_\_\_

Please indicate well location X.

ADDITIONAL INFORMATION

If more than one screen,  
show locations of each on sketch.