

PONTOTOC
A35
9-4-72

MISSISSIPPI
BOARD OF WATER COMMISSIONERS
416 North State Street
Jackson, Mississippi 39201

95000
4750
99950

WATER WELL DRILLERS LOG **CODED**

94 1972 *J T Medlin* Pontotoc
date well completed firm name county well located

LANDOWNER:
Douglas Graham
Hurricane
(mailing address)

description of formations encountered	from	to
<i>CLAY</i>	<i>0</i>	<i>26</i>
<i>SAND "</i>	<i>26</i>	<i>110</i>
<i>Blue "</i>	<i>110</i>	<i>381</i>
<i>PACKED SAND</i>	<i>381</i>	<i>500</i>

WELL LOCATION:
sec. *22* T *8* N R *1* E
3 miles *W* of *HURRICANE*
(distance) (direction) (nearest town)

WELL PURPOSE:
(home, irrigation, municipal, industrial)

- WELL COMPLETION DATA:
- (1) diameter (inches) *4*
 - (2) total depth (feet) *500*
 - (3) static water level (feet) *90* below above top of ground.
 - (4) casing *P* *150*
(material) (depth)
 - _____ If telescope see back.
(size)
 - (5) screen *0* _____
(length) (depth to top)
 - _____ (size) _____ (material)
 - (6) pump *15* *6*
(HP) (yield gpm)
 - E*
(type power)
 - (7) electric log _____
(yes or no)
 - _____ (organization running log)
 - (8) how well bottom plugged _____


CODED

OCT 12 1972

DRILLERS REMARKS:

If well telescopes please sketch and show depths.

GROUND LEVEL

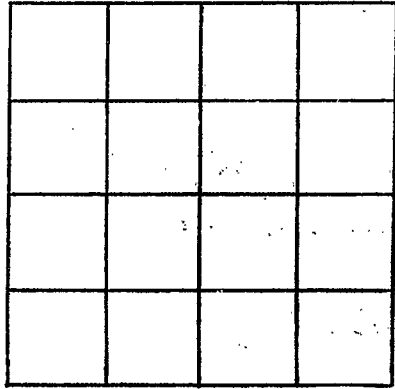

SECTION _____

Please indicate well location X.

ADDITIONAL INFORMATION

A series of horizontal lines for recording additional information.

If more than one screen, show locations of each on sketch.