

PONTOTOC
A37
10-25-72

MISSISSIPPI
 BOARD OF WATER COMMISSIONERS
 416 North State Street
 Jackson, Mississippi 39201

CODED

WATER WELL DRILLERS LOG

10-25- 1972 Leeper Drilling Pontotoc
 date well completed firm name county well located

LANDOWNER:	description of formations encountered	from	to
<u>Hazel Kison</u> <u>Rt 5 - Pontotoc</u> (mailing address)			

WELL LOCATION:
 sec 31 T 9 R 1 E
6 miles W of Pontotoc
 (distance) (direction) (nearest town)

WELL PURPOSE: Home
 (home, irrigation, municipal, industrial)

- WELL COMPLETION DATA:
- (1) diameter (inches) 4
 - (2) total depth (feet) 290'
 - (3) static water level (feet) 120' below top of ground above
 - (4) casing Steel 84'
 (material) (depth)
4 if telescope see back.
 (size)
 - (5) screen none
 (length) (depth to top)
 (size) (material)
 - (6) pump 1/2 7
 (HP) (yield gpm)
Elect-
 (type power)
 - (7) electric log NO
 (yes or no)
 (organization running log)
 - (8) how well bottom plugged open

CODED


DRILLERS REMARKS: _____

DEC 29 1972

If well telescopes please sketch and show depths.

GROUND LEVEL

168' drop pipe
1/2 5P27 Pump

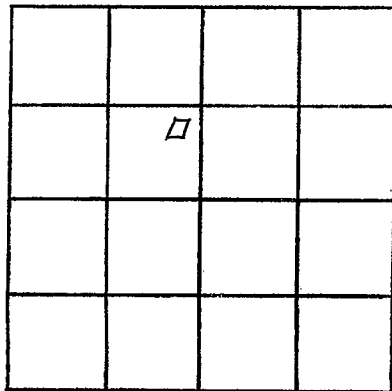

SECTION 31

Please indicate well location X.

ADDITIONAL INFORMATION

If more than one screen,
show locations of each on sketch.