

PONTOTOC  
A 38  
5-4-73

MISSISSIPPI  
BOARD OF WATER COMMISSIONERS  
416 North State Street  
Jackson, Mississippi 39201

CODF

WATER WELL DRILLERS LOG

May 4-73 date well completed     Naton Zuter firm name     Pontotoc county well located

LANDOWNER: Leroy Duskins  
Shaxton Miss.  
(mailing address)

description of formations encountered	from to	
<u>White Limestone</u>	<u>0</u>	<u>22</u>
<u>Limestone</u>	<u>22</u>	<u>45</u>
<u>Blue Shell</u>	<u>45</u>	<u>140</u>
<u>Black Shell</u>	<u>140</u>	<u>300</u>
<u>Rock + Sand</u>	<u>300</u>	<u>420</u>

WELL LOCATION:  
sec ~~23~~ 9 T 9 S R 1 E  
2 miles North of Hurricane  
(distance) (direction) (nearest town)

WELL PURPOSE: Home  
(home, irrigation, municipal, industrial)

- WELL COMPLETION DATA:
- (1) diameter (inches) 4 in.
  - (2) total depth (feet) 420 ft.
  - (3) static water level (feet) ~~400~~ 50 above top of ground.
  - (4) casing Steel, 105 (material), (depth)  
4" (size) if telescope see back.
  - (5) screen \_\_\_\_\_ (length) \_\_\_\_\_ (depth to top)  
(size) \_\_\_\_\_ (material)
  - (6) pump 1 HP 9 (HP) (yield gpm)  
2 stage Electric (type power)
  - (7) electric log \_\_\_\_\_ (yes or no)  
(organization running log)
  - (8) how well bottom plugged 0


GODEN

JUN 1 1973

DRILLERS REMARKS:

If well telescopes please sketch and show depths.

GROUND LEVEL

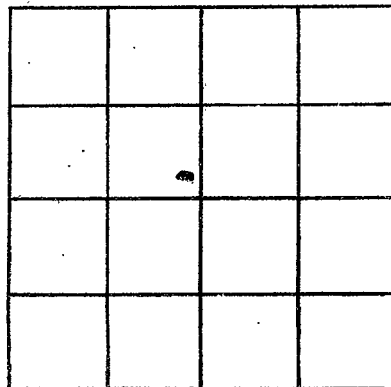

SECTION ~~24~~ 23

Please indicate well location X.

ADDITIONAL INFORMATION

If more than one screen,  
show locations of each on sketch.