

PONTOTOC
A 39
8-11-73

MISSISSIPPI
BOARD OF WATER COMMISSIONERS
416 North State Street
Jackson, Mississippi 39201

CODED

WATER WELL DRILLERS LOG

Aug 11 1973 Bobby L. Swords, Pontotoc
date well completed firm name county well located

LANDOWNER: HAROLD RUSSELL


description of formations encountered

from	to
0	30
30	60
60	150
150	360
360	418

White Loam
Limestone
Blue Shale
Blue limestone
Rock + Sand

(mailing address)

WELL LOCATION:

sec 34 T 8 N R 1  W

miles of (distance) (direction) (nearest town)

WELL PURPOSE: HOME USE
(home, irrigation, municipal, industrial)

WELL COMPLETION DATA:

- (1) diameter (inches) 4"
- (2) total depth (feet) 418.77
- (3) static water level (feet) 75 below above top of ground.
- (4) casing 84.77 (material) (depth)
4" (size) if telescope see back.
- (5) screen none (length) (depth to top)
(size) (material)
- (6) pump 1 HP 2 Stage 82PM (HP) (yield gpm)
ELECTRIC (type power)
- (7) electric log _____ (yes or no)
(organization running log)
- (8) how well bottom plugged _____

CODED


SEP 10 1973

DRILLERS REMARKS:

MISS. BD. OF
WATER COMM.

If well telescopes please sketch and show depths.

GROUND LEVEL

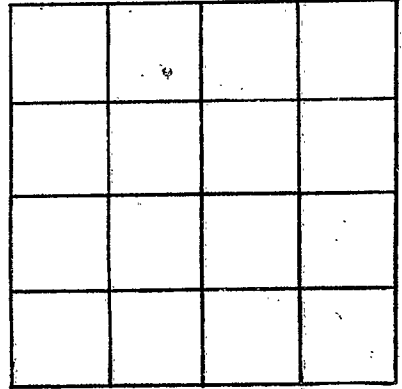

SECTION 34

Please indicate well location X.

ADDITIONAL INFORMATION

If more than one screen,
show locations of each on sketch.