

PONTOTOC
A40
8-17-73

MISSISSIPPI
BOARD OF WATER COMMISSIONERS
416 North State Street
Jackson, Mississippi 39201

CODED

WATER WELL DRILLERS LOG

Aug. 17 1973 Bobby L. Swords Pontotoc
date well completed firm name county well located

LANDOWNER: Tranny C. Montgomery

description of formations encountered

from to

RT. 2 Pontotoc, Miss.
(mailing address)

<u>Red Clay and sand</u>	<u>0</u>	<u>10</u>
<u>Blue Hard</u>	<u>10</u>	<u>370</u>
<u>Limestone</u>	<u>370</u>	<u>396</u>
<u>Rock + Sand</u>	<u>370</u>	<u>396</u>

WELL LOCATION:

sec. 26 T. 8 N. R. 10 E.
10 miles W. of ECRU
(distance) (direction) (nearest town)

WELL PURPOSE: Home use
(home, irrigation, municipal, industrial)

WELL COMPLETION DATA:

- (1) diameter (inches) 4"
- (2) total depth (feet) 396
- (3) static water level (feet) 74 below above top of ground.
- (4) casing Steel 84 ft.
(material) (depth)
4" if telescope see back.
(size)
- (5) screen none
(length) (depth to top)
(size) (material) 84 ft
- (6) pump 1 HP, 2 stage jet
(HP) (yield gpm)
Electric
(type power)
- (7) electric log (yes or no) _____
(organization running log) _____
- (8) how well bottom plugged _____

CODED


SEP 10 1973

DRILLERS REMARKS:

MISS. BU. OF
WATER

If well telescopes please sketch and show depths.

GROUND LEVEL

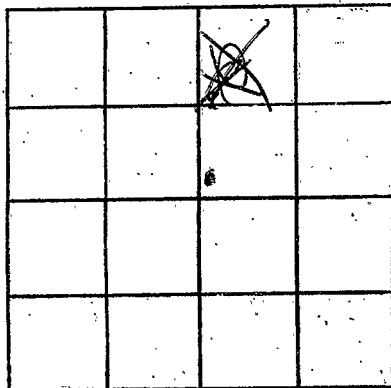

SECTION 26

Please indicate well location X.

ADDITIONAL INFORMATION

If more than one screen, show locations of each on sketch.