

PONTOTOC
A 41
7-30-73

MISSISSIPPI
BOARD OF WATER COMMISSIONERS
416 North State Street
Jackson, Mississippi 39201

CODED

WATER WELL DRILLERS LOG

7-30-1973
date well completed

Leepel Drill Co.
firm name

Pontotoc
county well located

LANDOWNER:
Gene Turner
Shayton, Miss.
(mailing address)

description of formations encountered.

from to

Red Clay	0	25
Red Clay & sand	25	80
Blue Clay	80	126
Blue Clay & Rock	126	300
Rock & Chalk	300	320
Chalk & streaks sand	320	360
Sand	360	425

WELL LOCATION:

sec. 10 T-9 S R-1 E
2 miles N of Shayton
(distance) (direction) (nearest town)

WELL PURPOSE: Home
(home, irrigation, municipal, industrial)

WELL COMPLETION DATA:

- (1) diameter (inches) 4
- (2) total depth (feet) 425
- (3) static water level (feet) 85 below above top of ground.
- (4) casing Steel, 126 (material) (depth)
4 (size) if telescope see back.
- (5) screen (length) (depth to top)
(size) (material)
- (6) pump 3/4 (HP) 10 (yield gpm)
Elect (type power)
- (7) electric log no- (yes or no)

CODED

(organization running log)


(8) how well bottom plugged Open

DRILLERS REMARKS:

LIFT 3 1/2

If well telescopes please sketch and show depths.

GROUND LEVEL

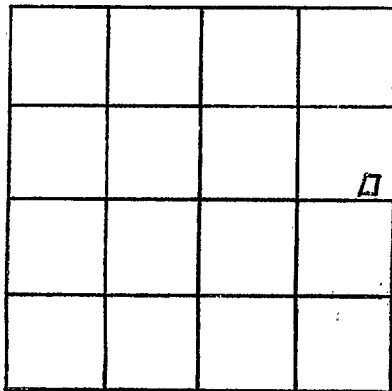

SECTION 10

Please indicate well location X.

ADDITIONAL INFORMATION

If more than one screen,
show locations of each on sketch.