

PONTOTOC

A 42

7-15-73

MISSISSIPPI  
 BOARD OF WATER COMMISSIONERS **CODED**  
 416 North State Street  
 Jackson, Mississippi 39201

WATER WELL DRILLERS LOG

7-15-1973  
date well completed

Leepool Drilling Co. - Pontotoc  
firm name county well located

LANDOWNER:

J. T. Graham  
Rt 1 - Hazton, Miss.  
(mailing address)

description of formations encountered

from

to

WELL LOCATION:

sec. 30 T 8 N R 1 E  
3 miles NE of LeFayette  
(distance) (direction) (nearest town)

WELL PURPOSE:

(home, irrigation, municipal, industrial)

WELL COMPLETION DATA:

- (1) diameter (inches) 4
- (2) total depth (feet) 729
- (3) static water level (feet) 190 below above top of ground
- (4) casing steel 3 1/2" (material) (depth)

(size) If telescope see back.

- (5) screen none (length) (depth to top)

(size) (material)

- (6) pump 1 (HP) 7 (yield gpm)

Elect (type power)

- (7) electric log no (yes or no)

(organization running log)


- (8) how well bottom plugged open

CODED

DRILLERS REMARKS:

If well telescopes please sketch and show depths.

GROUND LEVEL

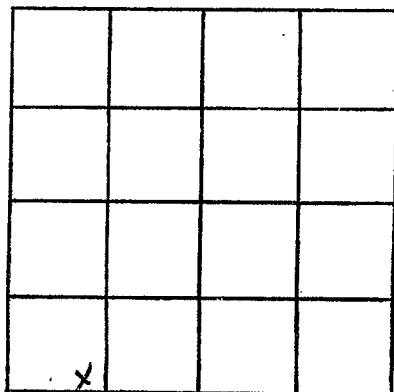

SECTION 30

Please indicate well location X.

ADDITIONAL INFORMATION

If more than one screen,  
show locations of each on sketch.