

PONTOTOC  
A 44  
2-20-74

MISSISSIPPI  
BOARD OF WATER COMMISSIONERS CODED  
416 North State Street  
Jackson, Mississippi 39201

WATER WELL DRILLERS LOG

2-20-1974 Leeper Pontotoc  
date well completed firm name county well located

LANDOWNER:  
Butch Novak  
Thaxter, Miss -  
(mailing address)

WELL LOCATION:  
sec. 14 T. 9 N R. 1 E  
2 miles S of Thaxter  
(distance) (direction) (nearest town)

WELL PURPOSE: Home  
(home, irrigation, municipal, industrial)

- WELL COMPLETION DATA:
- (1) diameter (inches) 4
  - (2) total depth (feet) 453
  - (3) static water level (feet) 80 below above top of ground.
  - (4) casing Steel, 105' (material) (depth)  
(size) If telescope see back.
  - (5) screen none (length) (depth to top)  
(size) (material)
  - (6) pump 1 (HP) 15 (yield gpm)  
Elect (type power)
  - (7) electric log no- (yes or no)  
(organization running log)
  - (8) how well bottom plugged open

description of formations encountered	from	to
Top soil & R. Clay	0	20
Red Clay & Red Sand	20	60
Blue Clay	60	105
Blue clay & Rock	105	350
Sand	350	453

CODED


RECEIVED  
MAR 21 1974

DRILLERS REMARKS:

MISS. BD. OF WATER COMMISSIONERS

If well telescopes please sketch and show depths.

GROUND LEVEL

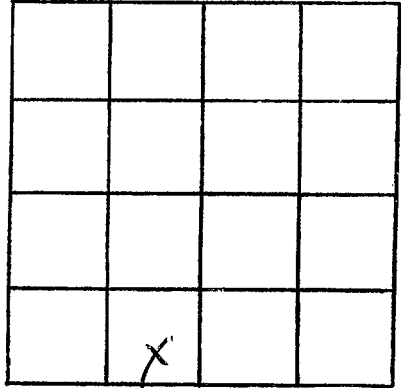

SECTION \_\_\_\_\_

Please indicate well location X.

ADDITIONAL INFORMATION

A series of horizontal lines for writing additional information, starting below the 'ADDITIONAL INFORMATION' header and extending to the bottom of the page.

If more than one screen, show locations of each on sketch.