

PONTOTOC

A 45

7-1-74

MISSISSIPPI BOARD OF WATER COMMISSIONERS
416 North State Street
Jackson, Mississippi 39201

CODED

WATER WELL DRILLERS LOG

July 1 1974 J. W. Wilkerson Pontotoc
date well completed firm name county well located

LANDOWNER: George Graham

description of formations encountered

from

to

Jocopsla

(mailing address)

| | | |
|------------------|-----|-----|
| Soil | 0 | 1 |
| Clay | 1 | 20 |
| Blue Rock + Sand | 40 | 290 |
| Blue Rock | 290 | 535 |
| Water Rock | 535 | 538 |
| Water sand | 538 | 640 |

WELL LOCATION:

sec. 6 T 95 N R 1 E
5 miles North of Jocopsla
(distance) (direction) (nearest town)

WELL PURPOSE:

(home, irrigation, municipal, industrial)

WELL COMPLETION DATA:

- (1) diameter (inches) 4"
- (2) total depth (feet) 640
- (3) static water level (feet) 168 below top of ground.
- (4) casing Steel, 295' (material) (depth)
- _____ if telescope see back. (size)
- (5) screen _____ (length) (depth to top)
- _____ (size) (material)
- (6) pump 1/2 HP, 10 (HP) (yield gpm)
- Elec (type power)
- (7) electric log _____ (yes or no)
- _____ (organization running log)
- (8) how well bottom plugged _____

CODED


DRILLERS REMARKS:

RECEIVED
AUG - 8 1974

MISS. BD. OF WATER COMMISSIONERS

If well telescopes please sketch and show depths.

GROUND LEVEL

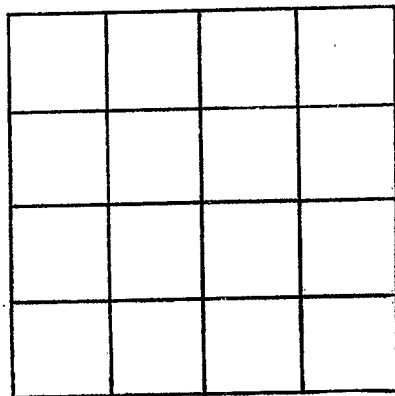

SECTION _____

Please indicate well location X.

ADDITIONAL INFORMATION

If more than one screen, show locations of each on sketch.