

MISSISSIPPI  
BOARD OF WATER COMMISSIONERS  
416 North State Street  
Jackson, Mississippi 39201

15F

Pentstoe  
A 2000  
5-21-76

**WATER WELL DRILLERS LOG**

5-21- 1976 Zeppen Pentstoe  
date well completed firm name county well located

LANDOWNER:  
Shelton Hayes  
Chariton, Miss  
(mailing address)

description of formations encountered	from	to
	<u>Red Clay + Sand</u>	<u>0</u>
<u>Blue Clay + Rock</u>	<u>20</u>	<u>80</u>
<u>Blue Clay</u>	<u>80</u>	<u>130</u>
<u>Blue Clay + Rock</u>	<u>130</u>	<u>300</u>
<u>Chalk + Rock</u>	<u>300</u>	<u>400</u>
<u>Sand + Rock</u>	<u>400</u>	<u>520</u>

WELL LOCATION:  
sec. 33 T-8 S R-1 E  
7 miles W of Pentstoe  
(distance) (direction) (nearest town)

WELL PURPOSE: Home  
(home, irrigation, municipal, industrial)


- WELL COMPLETION DATA:
- (1) diameter (inches) 4
  - (2) total depth (feet) 520
  - (3) static water level (feet) 140 below top of ground.
  - (4) casing Steel, 126,  
(material) (depth)  
(size) if telescope see back.
  - (5) screen Open  
(length) (depth to top)  
(size) (material)
  - (6) pump 1 10  
(HP) (yield gpm)  
Electric  
(type power)
  - (7) electric log no  
(yes or no)  
(organization running log)
  - (8) how well bottom plugged open

**RECEIVED**  
DEC 9 1976

DRILLERS REMARKS:

If well telescopes please sketch and show depths.

GROUND LEVEL

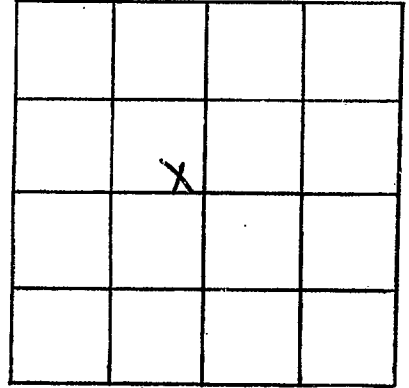

SECTION 33

Please indicate well location X.

ADDITIONAL INFORMATION

If more than one screen,  
show locations of each on sketch.