

Pontotoc
A 2001
5-4-77

MISSISSIPPI
 BOARD OF WATER COMMISSIONERS
 416 North State Street
 Jackson, Mississippi 39201

WATER WELL DRILLERS LOG

5-4- 19 77 Leeper Pontotoc
 date well completed firm name county well located

LANDOWNER:
Roger Burk
Thaxton, Miss.
 (mailing address)

description of formations encountered	from	to
<u>Top Soil + clay</u>	<u>0</u>	<u>15</u>
<u>White clay</u>	<u>15</u>	<u>60</u>
<u>Blue clay & Rock</u>	<u>60</u>	<u>90</u>
<u>Blue clay</u>	<u>90</u>	<u>140</u>
<u>Blue clay</u>	<u>140</u>	<u>375</u>
<u>Sand -</u>	<u>375</u>	<u>425</u>

WELL LOCATION:
 sec 35 T 8 N R 1 E
S W
3 miles N of Thaxton
 (distance) (direction) (nearest town)

WELL PURPOSE: Home
 (home, irrigation, municipal, industrial)

- WELL COMPLETION DATA:
- (1) diameter (inches) 4
 - (2) total depth (feet) 425
 - (3) static water level (feet) 80 below above top of ground.
 - (4) casing Steel, 126'
 (material) (depth)
4 if telescope see back.
 (size)
 - (5) screen Open
 (length) (depth to top)
 (size) (material)
 - (6) pump 3/4 10
 (HP) (yield gpm)
Elect.
 (type power)
 - (7) electric log no
 (yes or no)
 (organization running log)
 - (8) how well bottom plugged

RECEIVED


JUN 27 1977

DRILLERS REMARKS:

MISS. BD. OF WATER COM.

If well telescopes please sketch and show depths.

GROUND LEVEL

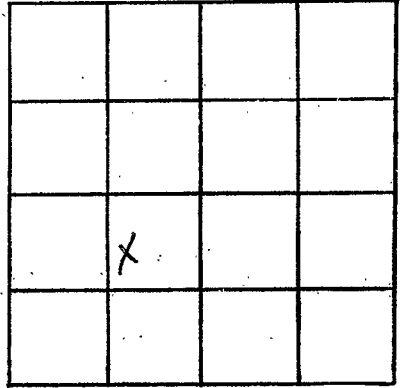

SECTION 35

Please indicate well location X.

ADDITIONAL INFORMATION

If more than one screen, show locations of each on sketch.