

PONTOTOC
A 2002
5-10-77

MISSISSIPPI
 BOARD OF WATER COMMISSIONERS
 416 North State Street
 15F Jackson, Mississippi 39201

WATER WELL DRILLERS LOG

5-10-1977
 date well completed

Leeper
 firm name

Pontotoc
 county well located

LANDOWNER:

Richard Caren
 Thorton, Miss
 (mailing address)

description of formations encountered

from to

| | | |
|-------------------|------|------|
| Top soil & clay | 0 | 15 |
| White clay | 15 | 60 |
| Blue clay & Rocks | 60 | 90 |
| Blue clay | 90 | 140 |
| Blue clay | 140 | 37.5 |
| Sand | 37.5 | 425 |

WELL LOCATION:

sec. 35 T 8 R 1 E
 3 miles N of Thorton
 (distance) (direction) (nearest town)

WELL PURPOSE: home
 (home, irrigation, municipal, industrial)

WELL COMPLETION DATA:

- (1) diameter (inches) 4
- (2) total depth (feet) 425
- (3) static water level (feet) 80 below top of ground.
- (4) casing steel, 126' (material) (depth)
 4 (size) if telescope see back.
- (5) screen open (length) (depth to top)
- (6) pump 3/4 (HP) 10 (material) (yield gpm)
 Elect- (type power)
- (7) electric log no- (yes or no)

(organization running log)

(8) how well bottom plugged


DRILLERS REMARKS:

RECEIVED
 JUN 27 1977

MISS. BD. OF WATER COMMISSIONERS

If well telescopes please sketch and show depths.

GROUND LEVEL

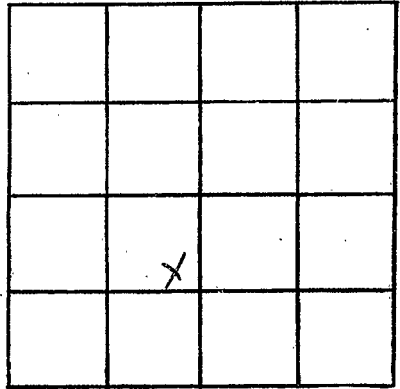

SECTION 35

Please indicate well location X.

ADDITIONAL INFORMATION

If more than one screen, show locations of each on sketch.