

PONTOTOC
A 2003
5-20-77

MISSISSIPPI
 BOARD OF WATER COMMISSIONERS
 416 North State Street
 Jackson, Mississippi 39201

WATER WELL DRILLERS LOG

5-20 1977
 date well completed

Leeper
 firm name

Pontotoc
 county well located


LANDOWNER:	description of formations encountered	from	to
<u>A. T. Rivera</u>			
<u>Rt 1 Thornton Miss</u> (mailing address)	<u>Blue Clay & Rock</u>	<u>20</u>	<u>80</u>
	<u>Blue Clay & Rock</u>	<u>80</u>	<u>290</u>
	<u>Sand</u>	<u>290</u>	<u>370</u>
WELL LOCATION:			
sec <u>23</u> T <u>9</u> R <u>1</u> E			
<u>6</u> miles <u>SW</u> of <u>Pontotoc</u>			
(distance) (direction) (nearest town)			
WELL PURPOSE: <u>home</u> (home, irrigation, municipal, industrial)			
WELL COMPLETION DATA:			
(1) diameter (inches) <u>4</u>			
(2) total depth (feet) <u>370</u>			
(3) static water level (feet) <u>85</u> below above top of ground.			
(4) casing <u>Steel, 126'</u> (material) (depth)			
<u>4</u> if telescope see back. (size)			
(5) screen <u>open</u> (length) (depth to top)			
(size) (material)			
(6) pump <u>3/4</u> <u>10</u> (HP) (yield gpm)			
<u>Elect</u> (type power)			
(7) electric log <u>No</u> (yes or no)			
(organization running log)			
(8) how well bottom plugged			
DRILLERS REMARKS:			

RECEIVED
 JUN 27 1977

MISS. BD. OF WATER COMMISSIONERS

If well telescopes please sketch and show depths.

GROUND LEVEL

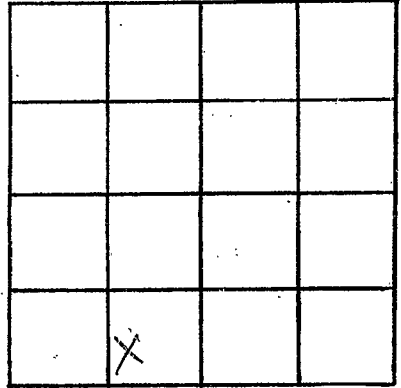

SECTION 23

Please indicate well location X.

ADDITIONAL INFORMATION

If more than one screen, show locations of each on sketch.