

PONTOTOC
A 2005
8-15

MISSISSIPPI
BOARD OF WATER COMMISSIONERS
416 North State Street
Jackson, Mississippi 39201

WATER WELL DRILLERS LOG

8-15-1977
date well completed

Leeper
firm name

Pontotoc
county well located

LANDOWNER:

Gail Luther
Rt 1 Pontotoc
(mailing address)

description of formations encountered

from to

White clay & Rock	0	30
Red sand & Rock	30	60
Blue clay	60	120
Blue clay & Rock	120	240
Chalk & Rock	240	300
Sand	300	385

WELL LOCATION:

sec. 23 T 9 S R 1 E
2 miles SE of Thorton
(distance) (direction) (nearest town)

WELL PURPOSE:

house
(home, irrigation, municipal, industrial)

WELL COMPLETION DATA:

- (1) diameter (inches) 4
- (2) total depth (feet) 385
- (3) static water level (feet) 120 below top of ground.
- (4) casing Steel 126'
(material) (depth)
- (5) screen none
(length) (depth to top)
- (6) pump 3/4 10
(HP) (yield gpm)
- (7) electric log none
(yes or no)

(organization running log)

(8) how well bottom plugged open


DRILLERS REMARKS:

RECEIVED
NOV - 1 1977

MISS. BD. OF WATER COMMISSIONERS

If well telescopes please sketch and show depths.

GROUND LEVEL

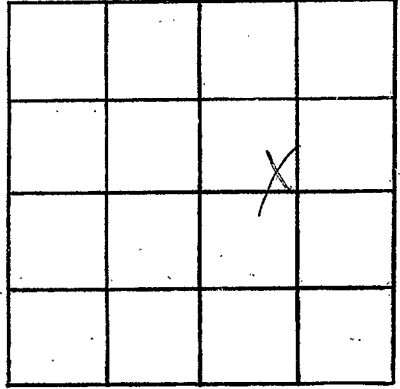

SECTION 23

Please indicate well location X.

ADDITIONAL INFORMATION

If more than one screen,
show locations of each on sketch.