

PONTOTOC

A2000

3-30-78

MISSISSIPPI BOARD OF WATER COMMISSIONERS  
416 North State Street  
Jackson, Mississippi 39201

WATER WELL DRILLERS LOG

3-30

1978

Leper

Pontotoc

date well completed

firm name

county well located

LANDOWNER:

John Miles

Reynolds St. Pontotoc  
(mailing address)

description of formations encountered

from

to

Clay  
Chalk  
Sand

0 250  
250 350  
350 420

WELL LOCATION:

sec. 34 T 8 N R 1 E  
S W

3 miles SE of Hurricane  
(distance) (direction) (nearest town)

WELL PURPOSE: Home  
(home, irrigation, municipal, industrial)

WELL COMPLETION DATA:

- (1) diameter (inches) 4
- (2) total depth (feet) 420'
- (3) static water level (feet) 120 <sup>below</sup> top of ground

(4) casing <sup>Steel</sup> 105'  
(material) (depth)

(size) if telescope see back.

(5) screen (length) (depth to top)

(size) (material)

(6) pump 3/4 10  
(HP) (yield gpm)

Electric  
(type power)

(7) electric log no  
(yes or no)

(organization running log)

(8) how well bottom plugged open

DRILLERS REMARKS:


RECEIVED

MAY 5 - 1978

MISS. BD. OF WATER COMMISSIONERS

If well telescopes please sketch and show depths.

GROUND LEVEL

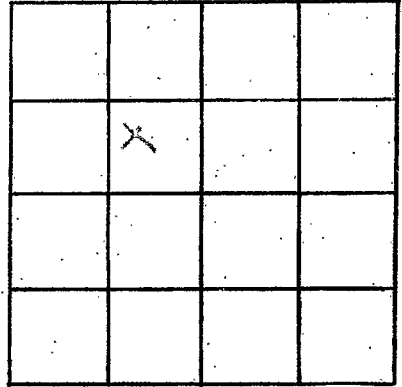

SECTION 34

Please indicate well location X.

ADDITIONAL INFORMATION

If more than one screen,  
show locations of each on sketch.