

PONTOTOC
A 2007
8-11-78

**MISSISSIPPI  
BOARD OF WATER COMMISSIONERS**  
416 North State Street  
Jackson, Mississippi 39201

**WATER WELL DRILLERS LOG**

8-11-1978 Leper Pontotoc  
 date well completed firm name county well located

**LANDOWNER:**  
Tommy Dullion  
Rt. 1 Shanton  
 (mailing address)

description of formations encountered	from	to
	<u>sands</u>	0
<u>top clay</u>	40	480
<u>loam shales</u>		
<u>water bearing sand</u>	480	560

**WELL LOCATION:**  
 sec 26 T 8 N R R1E ?  
5 miles N of Hummer  
 (distance) (direction) (nearest town)

**WELL PURPOSE:** Home  
 (home, irrigation, municipal, industrial)

**WELL COMPLETION DATA:**

(1) diameter (inches) 4

(2) total depth (feet) 560'

(3) static water level (feet) 140 <sup>below</sup> above top of ground.

(4) casing 40 BVC  
 (material) (depth)

\_\_\_\_\_ if telescope see back.  
 (size)

(5) screen \_\_\_\_\_  
 (length) (depth to top)

\_\_\_\_\_ (size) \_\_\_\_\_ (material)

(6) pump 3/4 10  
 (HP) (yield gpm)

Elec  
 (type power)

(7) electric log no  
 (yes or no)

\_\_\_\_\_ (organization running log)

(8) how well bottom plugged open


**DRILLERS REMARKS:**

**RECEIVED  
OCT 10 1978**

MISS. Bd. OF WATER COMMISSIONERS

If well telescopes please sketch and show depths.

GROUND LEVEL

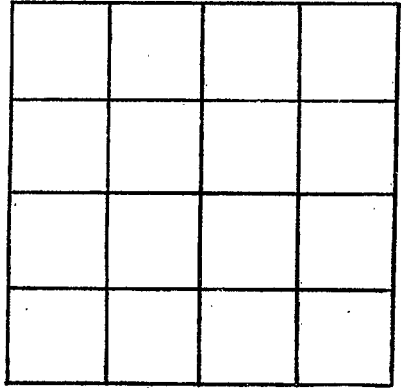

SECTION \_\_\_\_\_

Please indicate well location X.

ADDITIONAL INFORMATION

If more than one screen,  
show locations of each on sketch.