

PONTOTOC  
 A 2008  
 9-79

MISSISSIPPI  
 BOARD OF WATER COMMISSIONERS  
 416 North State Street  
 Jackson, Mississippi 39201

WATER WELL DRILLERS LOG


CODED  
 Pontotoc

Sept. 19 1979 date well completed  
 P. LEPPER Drilling firm name  
 Pontotoc county well located

LANDOWNER:	description of formations encountered	from	to
Charles E. Bray Rt 1 Pontotoc Hurricane Community	Top gumbo Blue clay Chalk Sand	0 40 280 350	40 280 350 410
WELL LOCATION: sec. 35 T 8 N R 1 E S (distance) miles (direction) of (nearest town)			
WELL PURPOSE: Home (home, irrigation, municipal, industrial)			
WELL COMPLETION DATA: (1) diameter (inches) 4 1/2 (2) total depth (feet) 410 FT (3) static water level (feet) 60 below top of ground. (4) casing PVC 105 FT (material) (depth) 4" (size) If telescope see back. (5) screen NONE (length) (depth to top) (6) pump 1/2 (HP) 70 gpm (material) (yield gpm) electric (type power) (7) electric log (yes or no) (organization running log) (8) how well bottom plugged			
DRILLERS REMARKS:			

If well telescopes please sketch and show depths.

GROUND LEVEL

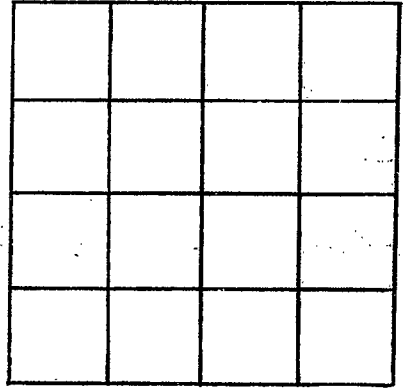

SECTION \_\_\_\_\_

Please indicate well location X.

ADDITIONAL INFORMATION

If more than one screen, show locations of each on sketch.