

MISSISSIPPI DEPARTMENT OF NATURAL RESOURCES

Bureau of Land and Water Resources

Southport Mall

P.O. Box 10631

Jackson, Mississippi 39209

WATER WELL DRILLERS LOG

Pontotoc
A 2009

9-8-79 date well completed

Leeper Drilling Pontotoc firm name

Pontotoc county well located

LANDOWNER:
Charles E. Brazz
Hurricane Community
 (mailing address)

description of formations encountered	from	to
Blue clay		
TOP clay	0	20
Blue clay	20	200
Chalk	200	380
Sand	380	410

WELL LOCATION:
 sec. 36 T. 8 N. R. 1 E.
2 miles (distance) S (direction) of Hurricane (nearest town)

WELL PURPOSE:
 (home, irrigation, municipal, industrial)

WELL COMPLETION DATA:

(1) diameter (inches) 4

(2) total depth (feet) 410

(3) static water level (feet) 80 below top of ground.

(4) casing WC 105 (material), (depth)
4" (size) If telescope see back.

(5) screen NONE (length), (depth to top)
 (size) (material)

(6) pump 1/2 (HP) 10 (yield gpm)
Electric (type power)

(7) electric log NO (yes or no)
 (organization running log)

(8) how well bottom plugged OPEN

DRILLERS REMARKS:


MISSISSIPPI DEPARTMENT OF NATURAL RESOURCES
 BUREAU OF LAND & WATER RESOURCES

MAY - 3 1982

RECEIVED

If well telescopes please sketch and show depths.

GROUND LEVEL

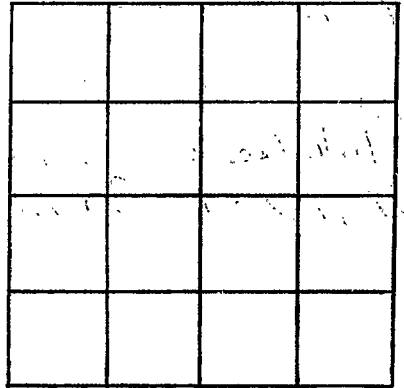

SECTION _____

Please indicate well location X.

ADDITIONAL INFORMATION

If more than one screen,
show locations of each on sketch.