

**MISSISSIPPI  
BOARD OF WATER COMMISSIONERS**  
416 North State Street  
Jackson, Mississippi 39201

**WATER WELL DRILLERS LOG**

Pontotoc  
A 2011

April 1986  
date well completed

LEEPER Drilling  
firm name

Pontotoc  
county well located

LANDOWNER: Bill McCarter  
Rt 1 Thaxton Ms

(mailing address)

**WELL LOCATION:**

sec. 27 T 9 N R 1 (E)  
10 miles SW of Pontotoc  
(distance) (direction) (nearest town)

WELL PURPOSE: Home  
(home, irrigation, municipal, industrial)

**WELL COMPLETION DATA:**

- (1) diameter (inches) 4"
- (2) total depth (feet) 675
- (3) static water level (feet) 160 below  
top of ground
- (4) casing PVC 400  
(material) (depth)  
4" If telescope see back.  
(size)
- (5) screen 60 615  
(length) (depth to top)  
2" steel pipe  
(size) (material)
- (6) pump 1 10  
(HP) (yield gpm)  
ELEC  
(type power)
- (7) electric log NO  
(yes or no)


(organization running log)

(8) how well bottom plugged well cap

description of formations encountered

from to

<u>Top clay</u>	<u>0</u>	<u>20</u>
<u>Blue clay</u>	<u>200</u>	<u>350</u>
<u>Chalk</u>	<u>350</u>	<u>450</u>
<u>SAND</u>	<u>450</u>	<u>500</u>
<u>Chalk</u>	<u>500</u>	<u>600</u>
<u>White Sand</u>	<u>600</u>	<u>675</u>

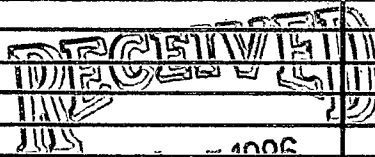


Department of Natural Resources  
Division of Land & Water Resources

DRILLERS REMARKS:

If well telescopes please sketch and show depths.

GROUND LEVEL

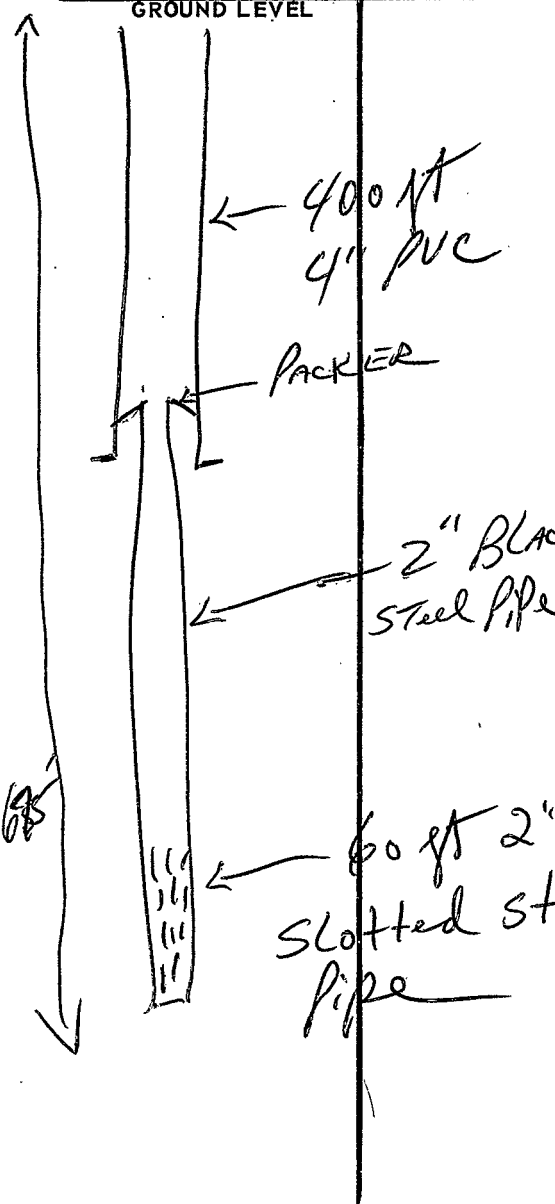


SECTION \_\_\_\_\_

Please indicate well location X.

ADDITIONAL INFORMATION

Lined area for additional information.

If more than one screen, show locations of each on sketch.