

MISSISSIPPI DEPARTMENT OF NATURAL RESOURCES

Bureau of Land and Water Resources

Southport Mall

P.O. Box 10631

Jackson, Mississippi 39209

WATER WELL DRILLERS LOG

Fontotoc  
A 2012

August 1987 Leeper Drilling Fontotoc  
date well completed firm name county well located

LANDOWNER: CASON Tutor  
Rt 1  
Randolph Ms.  
(mailing address)

WELL LOCATION:  
sec. 24 T. 9 N. R. 1 E.  
7 miles W of Fontotoc  
(distance) (direction) (nearest town)

WELL PURPOSE: HOME  
(home, irrigation, municipal, industrial)

- WELL COMPLETION DATA:
- (1) diameter (inches) 4"
  - (2) total depth (feet) 400 ft.
  - (3) static water level (feet) 90 below above top of ground.
  - (4) casing PVC 200'  
(material) (depth)  
4" if telescope see back.  
(size)
  - (5) screen NONE  
(length) (depth to top)  
(size) (material)
  - (6) pump 1 12  
(HP) (yield gpm)  
51cc  
(type power)
  - (7) electric log NO  
(yes or no)  
(organization running log)
  - (8) how well bottom plugged OPEN

description of formations encountered	from	to
<u>TOP CLAY</u>	<u>0</u>	<u>20</u>
<u>BLUE CLAY</u>	<u>20</u>	<u>250</u>
<u>CHALK</u>	<u>250</u>	<u>340</u>
<u>SAND</u>	<u>340</u>	<u>400</u>

RECEIVED


SEP 10 1987

Department of Natural Resources  
Bureau of Land & Water Resources

DRILLERS REMARKS:

If well telescopes please  
sketch and show depths.

GROUND LEVEL

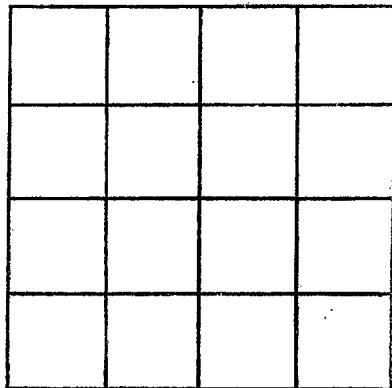

SECTION \_\_\_\_\_

Please indicate well location X.

ADDITIONAL INFORMATION

If more than one screen,  
show locations of each on sketch.