

MISSISSIPPI DEPARTMENT OF ENVIRONMENTAL QUALITY
Bureau of Land and Water Resources

P. O. Box 10631
Jackson, MS 39289-0631
WATER WELL DRILLERS LOG

COUNTY/WELL LOCATED PONTIAC	
WELL NUMBER A	CODED
DATE WELL COMPLETED 2017 April 1992	

PERMIT NUMBER
NAME OF DRILLING FIRM LEPER Drilling
PONTIAC

NAME & MAILING ADDRESS OF LANDOWNER Billy Hewlette RFD Thaxton, MS		
WELL LOCATION: SEC	TOWNSHIP	RANGE
27	9^N	1^E
DISTANCE	DIRECTION	NEAREST TOWN
_____ Miles	_____ of _____	
OTHER LANDMARK Fire tower Road		
WELL PURPOSE: Home, Irrigation, Municipal, Industrial, Fish Pond, etc. Home		

PUMP DATA		
PUMP TYPE (Circle One): <u>Submersible</u> , Turbine, Jet, Flowing Well, Other (Describe) _____		
POWER TYPE (Circle One): <u>Electric</u> , Tractor, Diesel, Gasoline, Butane, Other (Describe) _____ H/P _____		
Pump Capacity (GPM) 10	No. of Stages 11	Setting Depth 240 FT.
PUMP TEST		
Well yielded _____ GPM with a drawdown of _____ ft. after _____ hours of pumping		

WELL DATA		
Well Depth 560'	Casing Diameter (In.) 4"	Casing Length (Ft.) 280'
Type of Casing PVC	Hole Depth 560'	Depth to Static Water Level 195'
TYPE OF COMPLETION: (Circle One or More): Gravel Packed, Underreamed, <u>Telescoped</u> , Natural Development, Open Hole, Other _____ (Describe) _____		
Top of Lap Pipe or Reduction in Casing FEET IF TELESCOPED OR MORE THAN ONE SCREEN: USE BACK PAGE		

LOG DATA	
TYPE OF LOG RUN (Circle One): No Log Run, Electric, Gamma Ray, Density, Sonic, Neutron, Other (Describe) _____	
Name of Organization Running Log	

SCREEN DATA		
Diameter - Inches 2"	Length - Feet 40'	Slot Size - Inches 10/10
Screen Type Slotted PVC	Depth to Bottom - Feet 560'	

GEOLOGIC DATA (Office Use Only)			
Surface Elev.	Geologic Unit	Unit Thickness	Depth to Top
Subs. SWL	Date	Analysis	Aquifer Test

Driller's Remarks


DESCRIPTION OF FORMATIONS ENCOUNTERED	FROM	TO
TOP CLAY	0	20
BLUE CLAY	20	400
CHALK	400	500
SAND	500	560

FORMATIONS (Continued)	FROM	TO
RECEIVED		
MAY 04 1992		
Dept. of Environmental Quality Bureau of Land & Water Resources		

IF MORE SPACE IS NEEDED, USE BACK.

If well telescopes please
sketch and show depths.

GROUND LEVEL

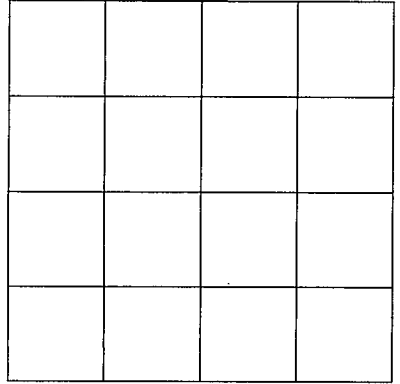

SECTION _____

Please indicate well location X.

ADDITIONAL INFORMATION

If more than one screen,
show location of each on sketch.