

PONTOTOC
 B 24
 2-18-71

MISSISSIPPI
 BOARD OF WATER COMMISSIONERS
 416 North State Street
 Jackson, Mississippi 39201

CODED

WATER WELL DRILLERS LOG

2-18 1971 Clark Bros. Pontotoc
 date well completed firm name county well located

LANDOWNER:
 Jimmy Wray
 Rt 2 - Pontotoc
 (mailing address)

description of formations encountered	from	to
Loam	0	20
Rock & Sand	20	50
Blue mud	50	200
Rock & Sand	200	264

WELL LOCATION:
 sec 33 T 8 R 2
 11 miles N.W. of Pontotoc
 (distance) (direction) (nearest town)

WELL PURPOSE: Home
 (home, irrigation, municipal, industrial)

- WELL COMPLETION DATA:
- (1) diameter (inches) 4"
 - (2) total depth (feet) 264'
 - (3) static water level (feet) 60' below top of ground.
 - (4) casing Metal, 166' (material) (depth)
 4" (size) if telescope see back.
 - (5) screen None (length) (depth to top)
 (size) (material)
 - (6) pump none (HP) (yield gpm)
 none (type power)
 - (7) electric log no (yes or no)
 (organization running log)
 - (8) how well bottom plugged no

CODED


DRILLERS REMARKS:

MAR 15 1971

MISSISSIPPI BOARD OF WATER COMMISSIONERS

If well telescopes please sketch and show depths.

GROUND LEVEL

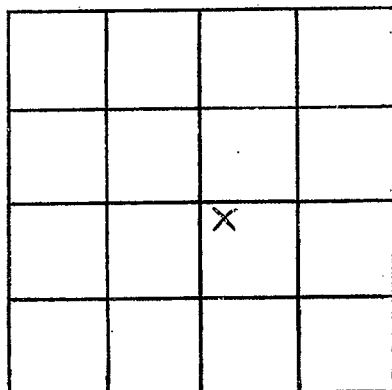

SECTION _____

Please indicate well location X.

ADDITIONAL INFORMATION

If more than one screen,
show locations of each on sketch.