

PONTOTOC
B26
5-1-71

MISSISSIPPI
BOARD OF WATER COMMISSIONERS
416 North State Street
Jackson, Mississippi 39201

CODED

WATER WELL DRILLERS LOG

5-1-71 19 LAMAR WELDER PONTOTOC
date well completed firm name county well located

LANDOWNER:
James Dowdy
Rt-1 New Albany
(mailing address)

description of formations encountered	from	to
<u>GREY SAND</u>	<u>0</u>	<u>70</u>
<u>LIMESTONE</u>	<u>70</u>	<u>90</u>
<u>BLUE SAND</u>	<u>90</u>	<u>357</u>
<u>TRICAL SAND</u>	<u>29</u>	<u>357</u>

WELL LOCATION:
sec 20 T 8 N 2 E
S W
4 miles W of ELKO
(distance) (direction) (nearest town)

WELL PURPOSE: HOME
(home, irrigation, municipal, industrial)

- WELL COMPLETION DATA:
- (1) diameter (inches) 4
 - (2) total depth (feet) 357
 - (3) static water level (feet) 20 below above top of ground.
 - (4) casing STEEL, 110
(material) (depth)
4 1/2 If telescope see back.
(size)
 - (5) screen NONE
(length) (depth to top)
(size) (material)
 - (6) pump 1/2 10
(HP) (yield gpm)
ELECT
(type power)
 - (7) electric log NO
(yes or no)
(organization running log)
 - (8) how well bottom plugged _____


CODED

MAY 14 1971

DRILLERS REMARKS: _____
MISS. BD. OF WATER COMM.

If well telescopes please sketch and show depths.

GROUND LEVEL

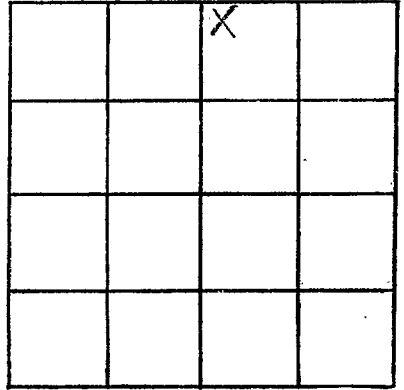

SECTION 28

Please indicate well location X.

ADDITIONAL INFORMATION

If more than one screen,
show locations of each on sketch.