

B28
3-9-63

WATER WELL DRILLERS LOG

CODED

Date Nov 9, 1963, Driller Gal Dorough County Pontotoc
(Name)

(1) Owner of Land: Eyes Dickey
(Name)
Pine Dale, Miss
(Address)
23852E

(2) Location: 1/4, 1/4, Sec. T R
12 miles Southwest of New Albany
(distance) (direction) (Nearest Town)

(3) Topography: (Hilly) (Flat) (Level)

(4) Purpose of Well: Home well
(Domestic Irrigation
Municipal, Industrial, Other)

Description & Color of Materials Sand, Clay, Red Clay, Shell, etc.	Thick- ness Feet	Depth Feet
<u>Red clay sand</u>	<u>14</u>	<u>70</u>
<u>Blue clay</u>	<u>400</u>	<u>84</u>

Information upon completion of well:

(1) Diameter 4 inches.

(2) Total Depth 490 feet.

(3) Water Level 70 feet below top of ground.

(4) Cased to 84, Size 4.

(5) Screen: Size none, Length _____.


(6) Were any formations sealed against pollution?
_____ yes, _____ no.

If YES depth of formation _____

Why _____

Drillers Remarks: _____

CODED

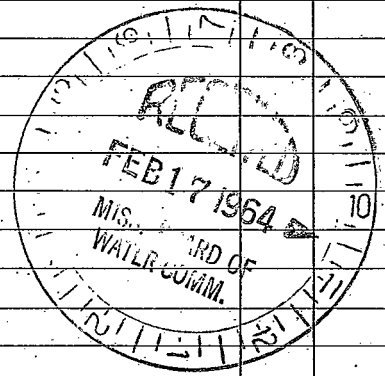

(Use Back Side)

Well No.

