

15 F

CODED

MISSISSIPPI  
 BOARD OF WATER COMMISSIONERS  
 416 North State Street  
 Jackson, Mississippi 39201

WATER WELL DRILLERS LOG

Pontotoc  
 B 30  
 10-19-68

10-19 1968 LAMAR WILDER PONTOTOC  
 date well completed firm name county well located

LANDOWNER:  
 MRS. TROY HUEY  
 RT 2 - PONTOTOC  
 (mailing address)


description of formations encountered	from	to
white loam	6	19
limestone	18	24
Brown SAND	24	40
BLUE SHALE	40	96
ROCK & SAND	96	180

WELL LOCATION:  
 sec. 1 T 9 N R 2 E  
 S 5  
 2 miles S of ECU  
 (distance) (direction) (nearest town)

WELL PURPOSE: Home  
 (home, irrigation, municipal, industrial)

- WELL COMPLETION DATA:
- (1) diameter (inches) 4
  - (2) total depth (feet) 212
  - (3) static water level (feet) 70 below above top of ground.
  - (4) casing STEEL, 8 1/2"  
 (material) (depth)  
 4 1/2" if telescope see back.  
 (size)
  - (5) screen ~~\_\_\_\_\_~~  
 (length) (depth to top)  
 (size) (material)
  - (6) pump 1/3 7  
 (HP) (yield gpm)  
 ELECTRIC  
 (type power)
  - (7) electric log NO  
 (yes or no)  
 (organization running log)
  - (8) how well bottom plugged \_\_\_\_\_


CODED

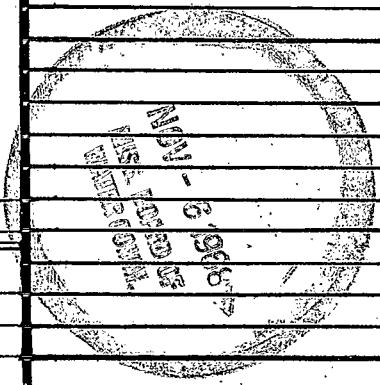

DRILLERS REMARKS:

If well telescopes please sketch and show depths.

GROUND LEVEL

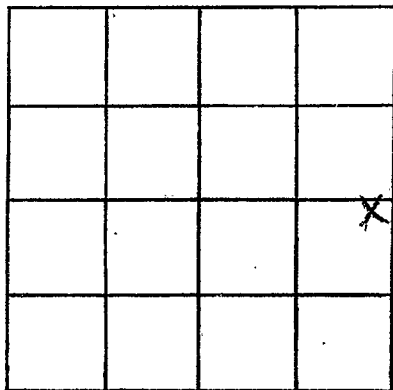

SECTION 1

Please indicate well location X.

ADDITIONAL INFORMATION

If more than one screen,  
show locations of each on sketch.