

MODEL

MISSISSIPPI  
BOARD OF WATER COMMISSIONERS  
416 North State Street  
Jackson, Mississippi 39201

WATER WELL DRILLERS LOG

Pontotoc  
B 31  
1-5-69

1-5-69 19 LAMAR WILBER PONTOTOC  
date well completed firm name county well located

LANDOWNER:

Ken Davis

Rt 1-Box

(mailing address)

description of formations encountered

from

to

WHITE LOAM

0

21

BLACK SHALE

21

55

~~BLUE SHALE~~

LIMESTONE

55

80

BLUE SHALE

80

98

ROCK SAND

98

140

WELL LOCATION:

sec 36 T 8 N R 2 E  
25 W  
2 miles SW of ECHU  
(distance) (direction) (nearest town)

WELL PURPOSE: Home  
(home, irrigation, municipal, industrial)

WELL COMPLETION DATA:

- (1) diameter (inches) 4
- (2) total depth (feet) 140
- (3) static water level (feet) 60 below above top of ground.
- (4) casing STEEL, 90 (material), (depth),  
if telescope see back.  
(size)
- (5) screen (length), (depth to top)  
(size), (material)
- (6) pump 1/2 4 (HP) (yield gpm)  
ELECT (type power)
- (7) electric log (yes or no)  
(organization running log)
- (8) how well bottom plugged

INDEX


FEB 20 1969

MISS. Bd. OF WATER COM.

DRILLERS REMARKS:

If well telescopes please  
sketch and show depths.

GROUND LEVEL

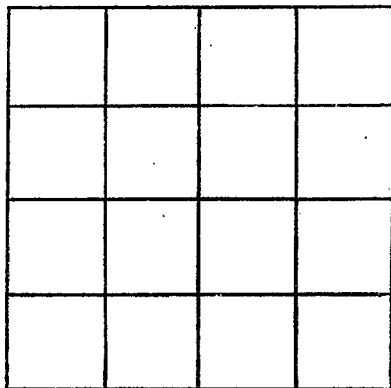

SECTION 36

Please indicate well location X.

ADDITIONAL INFORMATION

If more than one screen,  
show locations of each on sketch.