

CODED

MISSISSIPPI  
 BOARD OF WATER COMMISSIONERS  
 416 North State Street  
 Jackson, Mississippi 39201

CODED

WATER WELL DRILLERS LOG

Pontotoc  
 B 32  
 1-19-69

1-19-69 19 LAMAR WILDER PONTOTOC  
 date well completed firm name county well located

LANDOWNER:  
Alvis E. Goad  
1383 Whittaker  
Memph (mailing address)  
 WELL LOCATION:  
 sec 26 T 9 N R 2 E  
4 miles W of PONTOTOC  
 (distance) (direction) (nearest town)

description of formations encountered	from	to
BUCKSHOT	0	18
LYMESTONE	18	60
BLUE SHALE	60	110
ROCK SAND	110	160

WELL PURPOSE: HOME  
 (home, irrigation, municipal, industrial)


WELL COMPLETION DATA:  
 (1) diameter (inches) 14  
 (2) total depth (feet) 160  
 (3) static water level (feet) 80 below above top of ground.  
 (4) casing STEEL, 84,  
 (material) (depth)  
 (size) if telescope see back.  
 (5) screen \_\_\_\_\_ (length) (depth to top)  
 (size) (material)  
 (6) pump PUMP BY  
 (HP) (yield gpm)  
OTHERS  
 (type power)  
 (7) electric log \_\_\_\_\_ (yes or no)  
 (organization running log)  
 (8) how well bottom plugged \_\_\_\_\_

DRILLERS REMARKS:

DATE  
 FEB 28 1969  
 MISSISSIPPI  
 WATER WELL DRILLERS ASSOCIATION

If well telescopes please sketch and show depths.

GROUND LEVEL

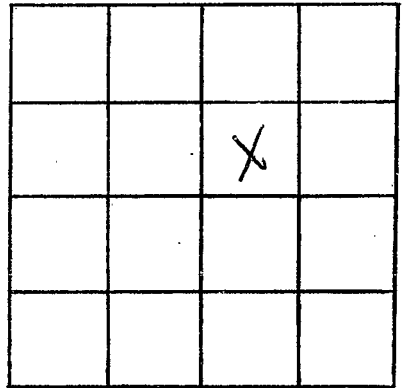

SECTION 26

Please indicate well location X.

ADDITIONAL INFORMATION

If more than one screen,  
show locations of each on sketch.