

CODED

PONTOTOC
B37
7-10-69

MISSISSIPPI
BOARD OF WATER COMMISSIONERS
416 North State Street
Jackson, Mississippi 39201

WATER WELL DRILLERS LOG

7-10 1969 Clark Bros Pontotoc
date well completed firm name county well located

LANDOWNER:
Billy Mack
Rt-2 Pontotoc
(mailing address)

description of formations encountered	from	to
limbs	0	15
Rock & sand	15	55
Blue mud	63	205
Rock & sand	205	308

WELL LOCATION:
sec 33 T 8 N R 2 E
S W
11 miles N-W of Pontotoc
(distance) (direction) (nearest town)

WELL PURPOSE: home
(home, irrigation, municipal, industrial)

- WELL COMPLETION DATA:
- (1) diameter (inches) 4
 - (2) total depth (feet) 308
 - (3) static water level (feet) 60 below top of ground.
 - (4) casing Metal 90 (material) (depth)
4 (size) If telescope see back.
 - (5) screen none (length) (depth to top)
 - (6) pump 1/2 Sub 7 (HP) (yield gpm)
Electric (type power)
 - (7) electric log 700 (yes or no)

(organization running log)

(8) how well bottom plugged 700


DRILLERS REMARKS:

AUG 7 1969

MISS. BD. OF
WATER COMM.

If well telescopes please sketch and show depths.

GROUND LEVEL

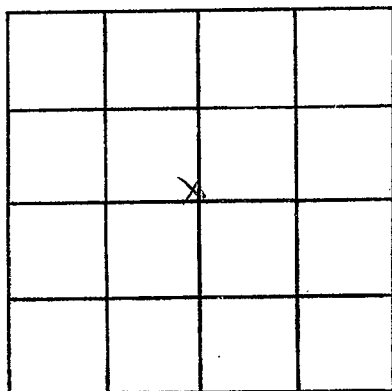

SECTION _____

Please indicate well location X.

ADDITIONAL INFORMATION

If more than one screen,
show locations of each on sketch.