

CODED

Pontotoc Co  
B 38  
7-69

MISSISSIPPI  
BOARD OF WATER COMMISSIONERS  
416 North State Street  
Jackson, Mississippi 39201

WATER WELL DRILLERS LOG

Pontotoc  
Union

7-11  
date well completed

1969 Clark Bros  
firm name

county well located

LANDOWNER:

Clifford S. Edwards  
Rt-2 Pontotoc  
(mailing address)

description of formations encountered

description of formations encountered	from	to
Shrubs	0	15
Rock & Sand	15	55
Blue mud	55	205
Rock & Sand	205	300

WELL LOCATION: 8N

sec. 34 T. 2 R. 2 E  
10 miles N-W of Pontotoc  
(distance) (direction) (nearest town)

WELL PURPOSE:

Home  
(home, irrigation, municipal, industrial)

WELL COMPLETION DATA:

- (1) diameter (inches) 4
- (2) total depth (feet) 300
- (3) static water level (feet) 60 below above top of ground.
- (4) casing Metal, 90  
(material) (depth)  
4 If telescope see back.  
(size)
- (5) screen none  
(length) (depth to top)  
(size) (material)
- (6) pump 1/2 Sub 7  
(HP) (yield gpm)  
Electric  
(type power)
- (7) electric log no  
(yes or no)  
(organization running log)
- (8) how well bottom plugged no


DRILLERS REMARKS:

AUG 7 1969

MISS. BD. OF  
WATER COMMISSIONERS

If well telescopes please sketch and show depths.

GROUND LEVEL

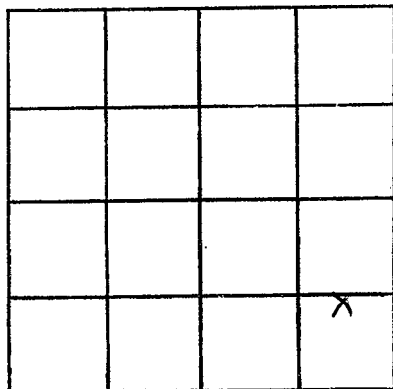

SECTION \_\_\_\_\_

Please indicate well location X.

ADDITIONAL INFORMATION

If more than one screen,  
show locations of each on sketch.