

MISSISSIPPI
BOARD OF WATER COMMISSIONERS
416 North State Street
Jackson, Mississippi 39201

WATER WELL DRILLERS LOG


Pontotoc
B 39
9-14-69

9-14-69 19 Lamar Wilder Pontotoc
date well completed firm name county well located

LANDOWNER:	description of formations encountered	from	to
<u>LYNN-W. Dowdy</u> <u>RT 1- ECHU, MISS</u> (mailing address)	<u>Grey Bwopshot</u> <u>Blueshale</u> <u>ROCK & SAND</u>	<u>0</u> <u>70</u> <u>120</u>	<u>20</u> <u>170</u> <u>170</u>
WELL LOCATION: sec <u>3</u> T <u>9</u> N R <u>2</u> E <u>4</u> miles <u>SW</u> of <u>ECHU</u> (distance) (direction) (nearest town)	<u>BLUE SHALE</u> <u>ROCK & SAND</u>	<u>170</u> <u>200</u>	<u>200</u> <u>252</u>
WELL PURPOSE: (home, irrigation, municipal, industrial)			
WELL COMPLETION DATA:			
(1) diameter (inches) <u>4</u>			
(2) total depth (feet) <u>252</u>			
(3) static water level (feet) <u>70</u> below top of ground.			
(4) casing <u>STEEL</u> , <u>92</u> , (material) (depth) <u>4"</u> (size) if telescope see back.			
(5) screen _____ (length) (depth to top) _____ (size) (material)			
(6) pump <u>PUMP SET</u> (HP) (yield gpm) <u>BY OWNER</u> (type power)			
(7) electric log <u>NO</u> (yes or no)			
(organization running log)			
(8) how well bottom plugged <u>NONE</u>			
DRILLERS REMARKS:	<p style="text-align: right;">SEP 17 1969</p> <p style="text-align: right;">MISSISSIPPI BOARD OF WATER COMMISSIONERS</p>		

If well telescopes please sketch and show depths.

GROUND LEVEL

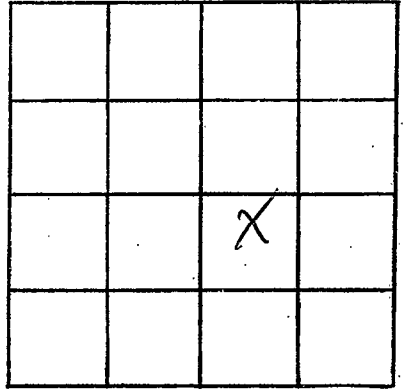

SECTION 3

Please indicate well location X.

ADDITIONAL INFORMATION

If more than one screen,
show locations of each on sketch.