

MISSISSIPPI
 BOARD OF WATER COMMISSIONERS
 416 North State Street
 Jackson, Mississippi 39201

CODED

WATER WELL DRILLERS LOG

Pontotoc
B 40
10-24-69

Oct 26 1969 J. W. Webherson Pontotoc
 date well completed firm name county well located

LANDOWNER: James Westmoreland

description of formations encountered	depth	
	from	to
<u>soil</u>	<u>0</u>	<u>11</u>
<u>sand + shell</u>	<u>11</u>	<u>57</u>
<u>Blue Rock</u>	<u>57</u>	<u>91</u>
<u>Water sand</u>	<u>91</u>	<u>200</u>
<u>Ripley</u>		

E. C. M. Miss
 (mailing address)

WELL LOCATION:
 sec. 11 T. 95 N. R. 2 E.
 S. W.

4 miles S west of Endicott
 (distance) (direction) (nearest town)

WELL PURPOSE:
 (home, irrigation, municipal, industrial)

WELL COMPLETION DATA:

(1) diameter (inches) 4

(2) total depth (feet) 200

(3) static water level (feet) 118 below top of ground.

(4) casing Steel, 63 ft
 (material) (depth)

4"
 (size) if telescope see back.

(5) screen _____
 (length) (depth to top)

 (size) (material)

(6) pump 3/4 hp 3
 (HP) (yield gpm)

Elec.
 (type power)

(7) electric log _____
 (yes or no)

 (organization running log)

(8) how well bottom plugged _____


DRILLERS REMARKS:

DEC - 8 1969

MISS. RD. DE
 WATER COMM.

If well telescopes please sketch and show depths.

GROUND LEVEL

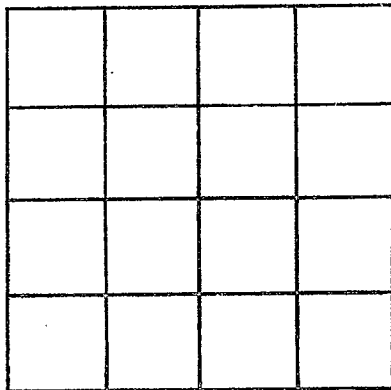

SECTION _____

Please indicate well location X.

ADDITIONAL INFORMATION

If more than one screen,
show locations of each on sketch.