

CODED

Pontotoc

BA1

11-10-69

MISSISSIPPI BOARD OF WATER COMMISSIONERS
416 North State Street
Jackson, Mississippi 39201

WATER WELL DRILLERS LOG

NOV 10 1969 J. W. Webb & Sons Pontotoc
date well completed firm name county well located

LANDOWNER: William Mathews

description of formations encountered

from to

Ecru Miss
(mailing address)

Soil	0	19
Blue sand & clay	19	38
Blue Rock	38	100
Water sand	100	210
Riprap		

WELL LOCATION:

sec. 11 T. 9 N. R. 2 E
S W
4 miles South of Ecru
(distance) (direction) (nearest town)

WELL PURPOSE:
(home, irrigation, municipal, industrial)

WELL COMPLETION DATA:

- (1) diameter (inches) 4
- (2) total depth (feet) 210
- (3) static water level (feet) 56 below top of ground
- (4) casing Steel, 44' (material), (depth)
4 (size) if telescope see back.
- (5) screen (length) (depth to top)
(size) (material)
- (6) pump H Jet 5 (AP) (yield gpm)
Elec (type power)
- (7) electric log (yes or no)
(organization running log)
- (8) how well bottom plugged


DEC 8 1969

MISS. BD. OF WATER COMMISSIONERS

DRILLERS REMARKS:

If well telescopes please sketch and show depths.

GROUND LEVEL

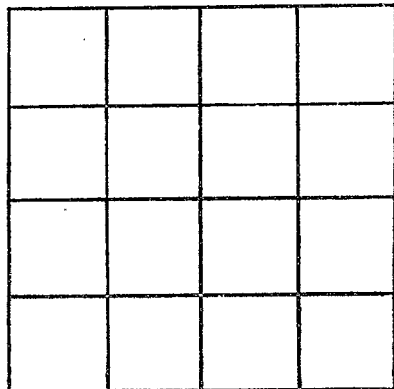

SECTION _____

Please indicate well location X.

ADDITIONAL INFORMATION

If more than one screen, show locations of each on sketch.