

Pontotoc
B44
1-27-70

MISSISSIPPI
BOARD OF WATER COMMISSIONERS
416 North State Street
Jackson, Mississippi 39201

CODED

WATER WELL DRILLERS LOG

1-27 1970 Clark Bros. Pontotoc
date well completed firm name county well located

LANDOWNER:
Gerald Robines
Essex St-1
(mailing address)

description of formations encountered	from	to
Shunko	0	12
Rock & Sand	12	50
Blue mud	50	110
Rock & Sand	110	200

WELL LOCATION:
sec. 11 T 9 N R 2 E
8 miles N-W of Pontotoc
(distance) (direction) (nearest town)

WELL PURPOSE: Home
(home, irrigation, municipal, industrial)

- WELL COMPLETION DATA:
- (1) diameter (inches) 4"
 - (2) total depth (feet) 200'
 - (3) static water level (feet) 30' below top of ground.
 - (4) casing Metal, 63' (material) (depth)
4" (size) if telescope see back.
 - (5) screen none (length) (depth to top)
(size) (material)
 - (6) pump 1/2 HP, 9 (HP) (yield gpm)
Electric (type power)
 - (7) electric log no (yes or no)
(organization running log)
 - (8) how well bottom plugged no


FEB 11 1970

MISS. BD. OF
WATER COMM.

DRILLERS REMARKS:

If well telescopes please sketch and show depths.

GROUND LEVEL

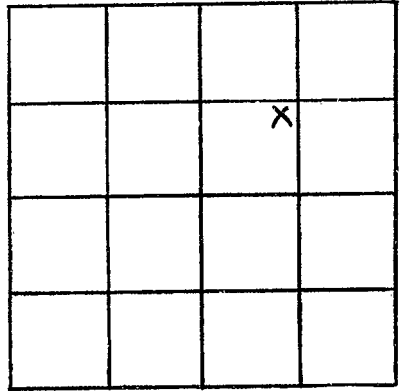

SECTION 11

Please indicate well location X.

ADDITIONAL INFORMATION

If more than one screen,
show locations of each on sketch.