

Pontotoc  
 B 45  
 3-26-70

MISSISSIPPI  
 BOARD OF WATER COMMISSIONERS  
 416 North State Street  
 Jackson, Mississippi 39201

CODED

WATER WELL DRILLERS LOG

3-26 1970 Clark Bros. Pontotoc  
 date well completed firm name county well located

LANDOWNER:  
 Billy Terry  
 Route 5 - Pontotoc  
 (mailing address)

description of formations encountered	from	to
Shale	0	20
Rock & Sand	20	50
Blue mud	50	170
Rock & Sand	170	220

WELL LOCATION:  
 sec. 29 T 9 S R 2 E  
 5 miles W of Pontotoc  
 (distance) (direction) (nearest town)

WELL PURPOSE: Home  
 (home, irrigation, municipal, industrial)

WELL COMPLETION DATA:

(1) diameter (inches) 4"

(2) total depth (feet) 220'

(3) static water level (feet) 70' below top of ground.

(4) casing Metal 84' (material) (depth)  
 4" (size) if telescope see back.

(5) screen None (length) (depth to top)  
 (size) (material)

(6) pump 1 1/2 HP (material) 6 (yield gpm)  
 Electric (type power)

(7) electric log No (yes or no)  
 (organization running log)

(8) how well bottom plugged No

CODED


APR 20 1970

MISS. BD. OF  
 WATER COM.

DRILLERS REMARKS:

If well telescopes please sketch and show depths.

GROUND LEVEL

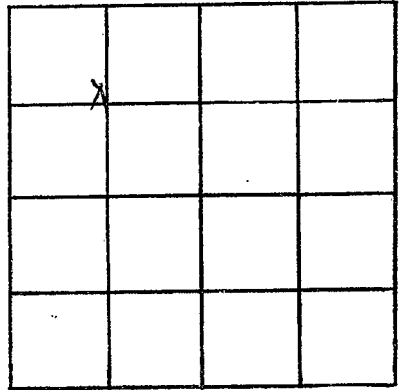

SECTION \_\_\_\_\_

Please indicate well location X.

ADDITIONAL INFORMATION

If more than one screen, show locations of each on sketch.