

Pontotoc
B 46
4-28-70

MISSISSIPPI
 BOARD OF WATER COMMISSIONERS
 416 North State Street
 Jackson, Mississippi 39201

WATER WELL DRILLERS LOG

date well completed 19 4-28-70 firm name LAMAR WILDER county well located PONTOTOC

LANDOWNER:
A-B-MCDONALD
RT-1-ECU
 (mailing address)
 WELL LOCATION: 165
 sec. 36 T. 28 S. R. 2 E.
1 miles SW of ECU
 (distance) (direction) (nearest town)

description of formations encountered	from	to
<u>GREY CLAY</u>	<u>8</u>	<u>20</u>
<u>LIMESTONE</u>	<u>20</u>	<u>60</u>
<u>BLUE SHALE</u>	<u>60</u>	<u>110</u>
<u>ROCK & SAND</u>	<u>110</u>	<u>165</u>

WELL PURPOSE: HOME
 (home, irrigation, municipal, industrial)

WELL COMPLETION DATA:

- (1) diameter (inches) 4
- (2) total depth (feet) 168
- (3) static water level (feet) 60 below above top of ground.
- (4) casing STEEL, 91 (material), (depth),
4" (size) if telescope see back.
- (5) screen NONE (length), (depth to top)
 (size), (material)
- (6) pump 3/4 6 (HP), (yield gpm)
ELECT (type power)
- (7) electric log NO (yes or no)

(organization running log)

(8) how well bottom plugged


JUN 4 1970

DRILLERS REMARKS:

MISS. BD. OF
 WATER COMM.

If well telescopes please sketch and show depths.

GROUND LEVEL

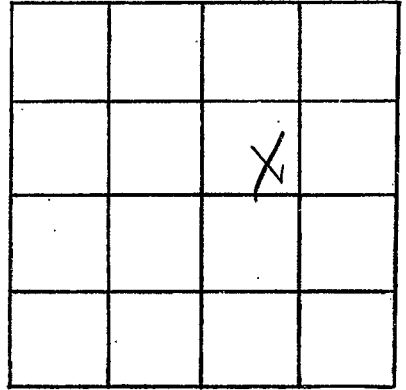

SECTION _____

Please indicate well location X.

ADDITIONAL INFORMATION

If more than one screen,
show locations of each on sketch.