

Pontotoc
 B 47.
 5-7-70
 3

MISSISSIPPI
 BOARD OF WATER COMMISSIONERS
 416 North State Street
 Jackson, Mississippi 39201

DB WATER WELL DRILLERS LOG

May 7 1970 J. W. Webb & Sons Pontotoc
 date well completed firm name county well located


LANDOWNER: Jim. Windham	description of formations encountered	from	to
Bene mis (mailing address)	Soil	0	11
WELL LOCATION: 027	blue sand & shell	11	49
sec. 12 9 2027 R 2 E	Blue Rock	49	107
3 miles south of Bene (distance) (direction) (nearest town)	Water Rock & Sand	107	200
WELL PURPOSE: (home, irrigation, municipal, industrial)	Ripley Sand		
WELL COMPLETION DATA:			
(1) diameter (inches) 5			
(2) total depth (feet) 200			
(3) static water level (feet) 57 below top of ground.			
(4) casing Steel, 53' (material) (depth)			
5 (size) if telescope see back.			
(5) screen 0 (length), 0 (depth to top)			
0 (size), 0 (material)			
(6) pump 1/2 hp (HP), 9 (yield gpm)			
Elec (type power)			
(7) electric log no (yes or no)			
(organization running log)			
(8) how well bottom plugged Open			
DRILLERS REMARKS:			

JUN 8 1970

MISS. BD. OF
 WA

If well telescopes please
sketch and show depths.

GROUND LEVEL

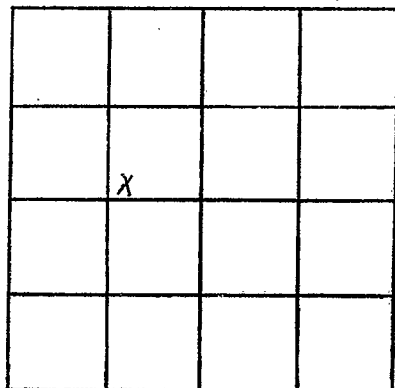

SECTION 12

Please indicate well location X.

ADDITIONAL INFORMATION

If more than one screen,
show locations of each on sketch.