

Pontotoc
B 48
6-6-70

MISSISSIPPI
BOARD OF WATER COMMISSIONERS
416 North State Street
Jackson, Mississippi 39201

CODED

cta 7-3-70

WATER WELL DRILLERS LOG

6-6 1970
date well completed

Ed Clark
firm name

Pontotoc
county well located

LANDOWNER:

description of formations encountered

from to

Lower shale
Pontotoc Route
(mailing address)

Clay	0	30
Rock of Sand	30	100
Blue sand	100	210
Rock of Sand	210	286

WELL LOCATION:

sec. 26 T-9N R-2E
11 miles N.W. of Pontotoc
(distance) (direction) (nearest town)

WELL PURPOSE:

Home
(home, irrigation, municipal, industrial)

WELL COMPLETION DATA:

- diameter (inches) 4"
- total depth (feet) 286'
- static water level (feet) 18' below top of ground.
- casing metal, 73' (material) (depth)
4" (size) if telescope see back.
- screen none (length) (depth to top)
none (size) (material)
- pump NO pump installed (HP) (yield gpm)
(type power)
- electric log (yes or no)
(organization running log)
- how well bottom plugged

CODED


JUL 1 1970

DRILLERS REMARKS:

MISS. BD. OF
WATER COMM.

If well telescopes please sketch and show depths.

GROUND LEVEL

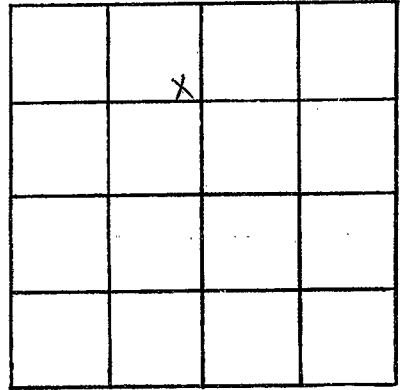

SECTION _____

Please indicate well location X.

ADDITIONAL INFORMATION

If more than one screen,
show locations of each on sketch.