

Pontotoc
B49
6-15-70

MISSISSIPPI
BOARD OF WATER COMMISSIONERS
416 North State Street
Jackson, Mississippi 39201

CODED

WATER WELL DRILLERS LOG

6-15 1970 Clark Bros. Pontotoc
date well completed firm name county well located

LANDOWNER:
Kenny Hunter
Pontotoc Route
(mailing address)

description of formations encountered	from	to
Red clay	0	30
Rock & Sand	30	
Clay	30	50
Red & Blue mud	50	180
Rock & Sand	180	220

WELL LOCATION:
sec. 15 T 9 S R 20 E
5 miles W of Pontotoc
(distance) (direction) (nearest town)

WELL PURPOSE: Home
(home, irrigation, municipal, industrial)

- WELL COMPLETION DATA:
- (1) diameter (inches) 4"
 - (2) total depth (feet) 220'
 - (3) static water level (feet) 70 below above top of ground.
 - (4) casing Metal, 100' (material) (depth)
4" if telescope see back. (size)
 - (5) screen None (length) (depth to top)
(size) (material)
 - (6) pump 1/2 Gal 7 (HP) (yield gpm)
Electric (type power)
 - (7) electric log no (yes or no)
(organization running log)
 - (8) how well bottom plugged no

CODED


JUL 1 1970

DRILLERS REMARKS:

MISS. BD OF
WATER COMM.

If well telescopes please sketch and show depths.

GROUND LEVEL

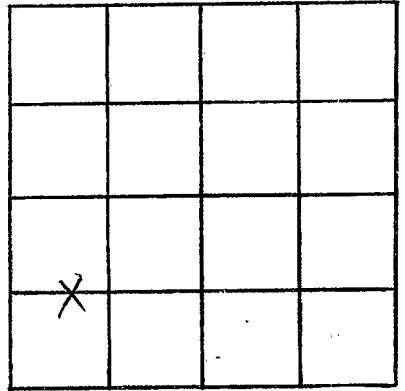

SECTION _____

Please indicate well location X.

ADDITIONAL INFORMATION

If more than one screen,
show locations of each on sketch.