

PONTOTOC
B51
9-20-70

MISSISSIPPI
 BOARD OF WATER COMMISSIONERS
 416 North State Street
 Jackson, Mississippi 39201

CODED

WATER WELL DRILLERS LOG

Sept 20 19 70 Clark Bros Pontotoc
 date well completed firm name county well located

LANDOWNER:
David Huffstaler
Rt 2 - Pontotoc
 (mailing address)

| description of formations encountered | from | to |
|---------------------------------------|------------|------------|
| <u>Soils</u> | <u>0</u> | <u>30</u> |
| <u>Rock & Sand</u> | <u>30</u> | <u>75</u> |
| <u>Blue mud</u> | <u>75</u> | <u>200</u> |
| <u>Rock & Sand</u> | <u>200</u> | <u>250</u> |

WELL LOCATION:
23 sec. 9 T. 9 N. R. 2 E.
4 1/2 miles NW of Pontotoc
 (distance) (direction) (nearest town)

WELL PURPOSE: none
 (home, irrigation, municipal, industrial)

- WELL COMPLETION DATA:
- (1) diameter (inches) 4"
 - (2) total depth (feet) 250'
 - (3) static water level (feet) 60' below above top of ground.
 - (4) casing metal, 84' (material) (depth)
4" (size) If telescope see back.
 - (5) screen None (length) (depth to top)
 (size) (material)
 - (6) pump 1 jet (HP) 7 (yield gpm)
Electric (type power)
 - (7) electric log no (yes or no)
 (organization running log)
 - (8) how well bottom plugged no

CODED


OCT 28 1970

DRILLERS REMARKS:

MISS. BD. OF
 WATER COMMISSIONERS

If well telescopes please sketch and show depths.

GROUND LEVEL

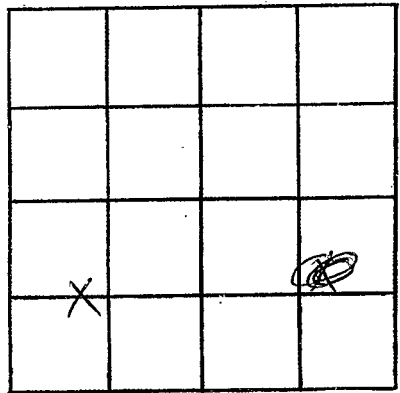

SECTION _____

Please indicate well location X.

ADDITIONAL INFORMATION

If more than one screen, show locations of each on sketch.