

MISSISSIPPI
BOARD OF WATER COMMISSIONERS
416 North State Street
Jackson, Mississippi 39201

CODED

WATER WELL DRILLERS LOG

PONTOTOC
B 52
9-25-70

Sept 25 1970 Clark Bros.
date well completed firm name

county well located

LANDOWNER:
William Haynes
Rt 4 - New Albany
(mailing address)

description of formations encountered	from	to
<u>Sand</u>	<u>0</u>	<u>25</u>
<u>Rock & Sand</u>	<u>25</u>	<u>60</u>
<u>Blue mud</u>	<u>60</u>	<u>120</u>
<u>Rock & Sand</u>	<u>120</u>	<u>200</u>

WELL LOCATION:
sec. 35 T 8 N R. 2 E
6 miles SW of New Albany
(distance) (direction) (nearest town)

WELL PURPOSE: Home
(home, irrigation, municipal, industrial)

- WELL COMPLETION DATA:
- (1) diameter (inches) 4"
 - (2) total depth (feet) 200'
 - (3) static water level (feet) 27' below above top of ground.
 - (4) casing Metal, 70'
(material) (depth)
4 if telescope see back.
(size)
 - (5) screen None
(length) (depth to top)
(size) (material)
 - (6) pump 3/4 hp 7
(HP) (yield gpm)
Electric
(type power)
 - (7) electric log no
(yes or no)
(organization running log) no
 - (8) how well bottom plugged

CODED


OCT 28 1970

MISS. BD. OF
WATER COMM.

DRILLERS REMARKS:

If well telescopes please sketch and show depths.

GROUND LEVEL

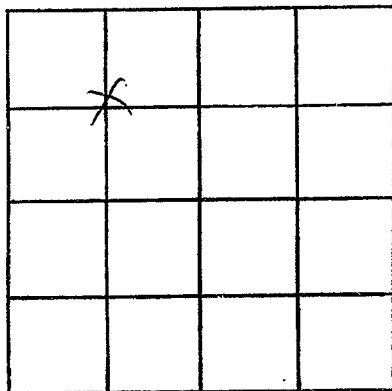

SECTION _____

Please indicate well location X.

ADDITIONAL INFORMATION

If more than one screen, show locations of each on sketch.