

PONTOTOC
B 56
12-14-70

MISSISSIPPI
BOARD OF WATER COMMISSIONERS
416 North State Street
Jackson, Mississippi 39201

WATER WELL DRILLERS LOG

CODED

12-14-70 date well completed 1970 Clark Bros. firm name Pontotoc county well located

LANDOWNER: James Swards
Rt-2, Pontotoc (mailing address)

description of formations encountered	from	to
Shales	0	30
Loam & Sand	30	60
Blue mud	60	180
Loam & Sand	180	200

WELL LOCATION:
sec. 27 T. 8 N. R. 2 E.
15 miles SSW of ~~Starkville~~ (nearest town)

WELL PURPOSE: Home (home, irrigation, municipal, industrial)

- WELL COMPLETION DATA:
- (1) diameter (inches) 4"
 - (2) total depth (feet) 226'
 - (3) static water level (feet) 45' below top of ground.
 - (4) casing Metal, 84' (material) (depth)
4" (size) if telescope see back.
 - (5) screen none (length) (depth to top)
(size) (material)
 - (6) pump 1 1/2 HP, 6 (yield gpm)
Electric (type power)
 - (7) electric log no (yes or no)
(organization running log)
 - (8) how well bottom plugged no

CODED


JAN 4 1971

AREA ED. OF
MISSISSIPPI
SECRETARY

DRILLERS REMARKS:

If well telescopes please sketch and show depths.

GROUND LEVEL

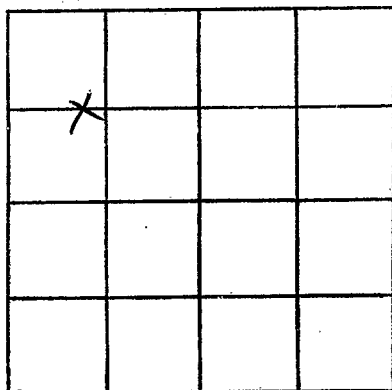

SECTION _____

Please indicate well location X.

ADDITIONAL INFORMATION

If more than one screen, show locations of each on sketch.