

MISSISSIPPI
BOARD OF WATER COMMISSIONERS
416 North State Street
Jackson, Mississippi 39201

CODED

WATER WELL DRILLERS LOG

PONTOTOC
B57
12-23-70

12-23 1970 Clark Bros Pontotoc
date well completed firm name county well located

LANDOWNER:
Stanley Wise
Rt-1, Pontotoc
(mailing address)

description of formations encountered	from	to
<u>2' sand</u>	<u>0</u>	<u>30</u>
<u>lime rock & sand</u>	<u>30</u>	<u>90</u>
<u>blue mud</u>	<u>90</u>	<u>210</u>
<u>rock & sand</u>	<u>210</u>	<u>286</u>

WELL LOCATION:
sec. 21 T8 S R. 2 E
16 miles NW of Pontotoc
(distance) (direction) (nearest town)

WELL PURPOSE: Phone
(home, irrigation, municipal, industrial)

- WELL COMPLETION DATA:
- (1) diameter (inches) 4"
 - (2) total depth (feet) 286'
 - (3) static water level (feet) 45' below above top of ground.
 - (4) casing Metal, 90'
(material) (depth)
4" if telescope see back.
(size)
 - (5) screen None
(length) (depth to top)
(size) (material)
 - (6) pump 4 Sub., 7
(HP) (yield gpm)
Electric
(type power)
 - (7) electric log no
(yes or no)
(organization running log)
 - (8) how well bottom plugged no

CODED


JAN 4 - 1971

MISS. RD. OF
WATER COMM.

DRILLERS REMARKS:

If well telescopes please sketch and show depths.

GROUND LEVEL

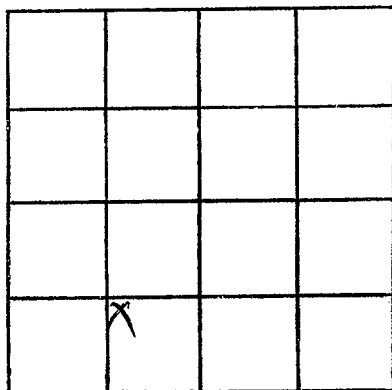

SECTION _____

Please indicate well location X.

ADDITIONAL INFORMATION

If more than one screen, show locations of each on sketch.