

MISSISSIPPI BOARD OF WATER COMMISSIONERS

PONTOTOC

B-59

8-22-60

**CODED**

WATER WELL DRILLERS LOG

B-301

Date: 8-22, 1960

Driller: J. J. Macey  
(Name)

County: Pontotoc

- (1) Owner of Land: L. C. Curran  
(Name)  
Pontotoc R.D. 2  
(Address)
- (2) Location: 1/2 mi. S, Sec. 27 T. 5 R. 2E  
1/2 miles S W, of Pontotoc  
(distance) (direction) (Nearest Town)
- (3) Topography: Hilly  
(Hilly) (Flat) (Level)
- (4) Purpose of Well: Domestic  
(Domestic Irrigation  
Municipal, Industrial, Other)

Description & Color of Materials Sand, Clay, Red Clay, Shell, etc.	Thick- ness Feet	Depth Feet
<u>Soil &amp; gravel</u>	<u>35</u>	<u>35</u>
<u>red shale</u>	<u>40</u>	<u>75</u>
<u>rock</u>	<u>35</u>	<u>110</u>
<u>red shale</u>	<u>5</u>	<u>115</u>
<u>red shale</u>	<u>20</u>	<u>135</u>
<u>red shale</u>	<u>5</u>	<u>140</u>
<u>red shale</u>	<u>15</u>	<u>155</u>


Information upon completion of well:

- (1) Diameter 4 inches.
- (2) Total Depth 204 feet.
- (3) Water Level 60 feet below top of ground.
- (4) Cased to 127, Size 4"
- (5) Screen: Size \_\_\_\_\_, Length \_\_\_\_\_
- (6) Were any formations sealed against pollution?  
Yes, \_\_\_\_\_ no.

If YES depth of formation to 31  
Why: \_\_\_\_\_

Drillers Remarks: \_\_\_\_\_  
\_\_\_\_\_  
\_\_\_\_\_

**CODED**

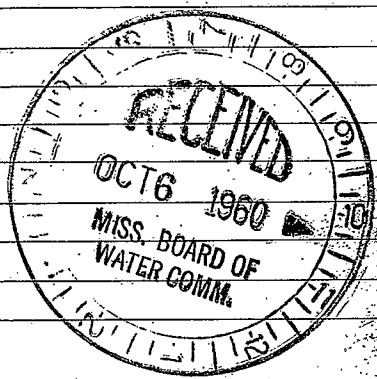

(Use Back Side)

Well No. B-301

