

MISSISSIPPI BOARD OF WATER COMMISSIONERS

PONTOTOC

B-60

8-24-60

CODED

WELL DRILLERS LOG B-300

Date: 8-24, 1960, Driller: J. S. Mabe County: Pontotoc
 (Name)

(1) Owner of Land: Mrs. H. A. Groves
 (Name)

Pontotoc R. D. 2
 (Address)

(2) Location: 1/2 NW 1/4, Sec. 22, T9R2

5 miles N west, of Pontotoc
 (distance) (direction) (Nearest Town)

(3) Topography: Hilly
 (Hilly) (Flat) (Level)

(4) Purpose of Well: Domestic
 (Domestic Irrigation, Municipal, Industrial, Other)

Description & Color of Materials Sand, Clay, Red Clay, Shell, etc.	Thick- ness Feet	Depth Feet
<u>Sand & clay</u>	<u>30</u>	<u>30</u>
<u>blue shale</u>	<u>45</u>	<u>75</u>
<u>Rock & turp</u>	<u>1/2</u>	<u>120</u>
<u>sand</u>	<u>5</u>	<u>125</u>
<u>Blue marl</u>	<u>42</u>	<u>130</u>
<u>rock</u>	<u>9</u>	<u>133</u>
<u>sand & rock</u>	<u>1/2</u>	<u>220</u>

Information upon completion of well:

(1) Diameter 4 inches.

(2) Total Depth 225 feet.

(3) Water Level 43 feet below top of ground.

(4) Cased to 134', Size _____

(5) Screen: Size _____, Length _____


(6) Were any formations sealed against pollution?
 _____ yes, _____ no.

If YES depth of formation _____

Why _____

Drillers Remarks: _____

CODED

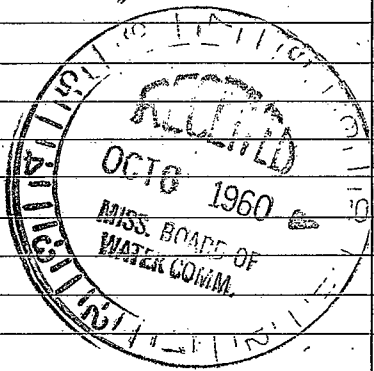

Well No. B300

(Use Back Side)

