

PONTOTOC

B-61

3-28-62

WATER WELL DRILLERS LOG

CODED

Date: 3-28, 1962, Driller: Y. H. [unclear] County: Pontotoc

(Name)

CODED

(1) Owner of Land: Jennie Branley

(Name)

Pontotoc R.R.D. 6

(Address)

(2) Location: 1/4 NW 1/4, Sec. 32 T9 R2

9 miles W of Pontotoc

(distance)

(direction)

(Nearest Town)

(3) Topography: V

(Hilly)

(Flat)

(Level)

(4) Purpose of Well: Domestic

(Domestic Irrigation, Municipal, Industrial, Other)

Description & Color of Materials Sand, Clay, Red Clay, Shell, etc.	Thick- ness Feet	Depth Feet
Red clay	26	30
Blue shale	106	140
Red	110	150
Red shale	60	210
Red & blue	15	225

Information upon completion of well:


- (1) Diameter 4 inches.
- (2) Total Depth 225 feet.
- (3) Water Level 60 feet below top of ground.
- (4) Cased to 44, Size
- (5) Screen: Size, Length
- (6) Were any formations sealed against pollution?  
yes, no.

If YES depth of formation

Why

Drillers Remarks:

CODED

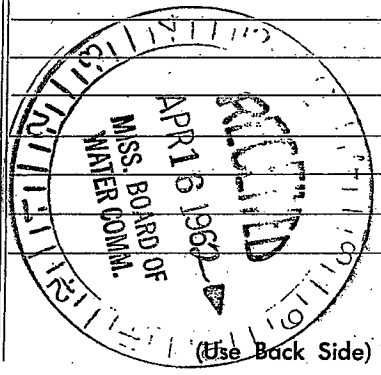

Well No.

Porter

3-22 12 1/2

James Porter

Porter R.D. 2

35 25  
Mrs Porter

2

X  
Demerol

X  
20  
20  
20