

CODED

Pontotoc
B-64
9-67

MISSISSIPPI
BOARD OF WATER COMMISSIONERS
416 North State Street
Jackson, Mississippi 39201

CODED

WATER WELL DRILLERS LOG

date well completed 19 67 9-22-67 firm name LAMAR WILDER county well located PONTOTOC

LANDOWNER: _____

description of formations encountered from to

F-A-HOLCOMB
TAYLOR, MISS
(mailing address)

GREY CLAY 0 15
GREY BOCKSHOT 15 140
BLUE SHALE 140 140
BLUE & WHITE SHALE 140 325
ROCK & SAND 325 370


WELL LOCATION:
sec. 19 T. 9 S. R. 2 E.
8 miles W of PONTOTOC
(distance) (direction) (nearest town)

WELL PURPOSE:
(home, irrigation, municipal, industrial)

WELL COMPLETION DATA:

- (1) diameter (inches) 4
- (2) total depth (feet) 370
- (3) static water level (feet) 35 below above top of ground.
- (4) casing STEEL, 118
(material) (depth)
4" if telescope see back.
(size)
- (5) screen _____
(length) (depth to top)
(size) (material)
- (6) pump 1/2 5
(HP) (yield gpm)
ELECTRIC
(type power)
- (7) electric log NO
(yes or no)
(organization running log)
- (8) how well bottom plugged _____

CODED

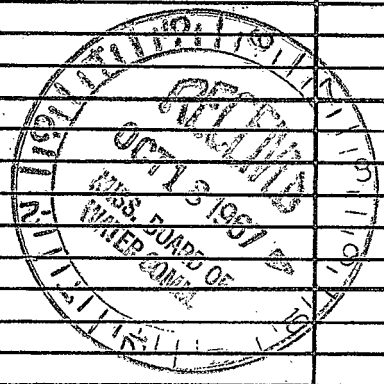

DRILLERS REMARKS: _____

If well telescopes please sketch and show depths.

GROUND LEVEL

			X

SECTION 19

Please indicate well location X.

ADDITIONAL INFORMATION

If more than one screen, show locations of each on sketch.