

# CODED

MISSISSIPPI  
BOARD OF WATER COMMISSIONERS  
416 North State Street  
Jackson, Mississippi 39201

# CODED

## WATER WELL DRILLERS LOG

Pontotoc  
B-65  
10-67

date well completed 10-4-67 firm name Lamar, Wilder county well located PONTOTOC

LANDOWNER: KIT & B EASTERLIND  
RT 5 - PONTOTOC  
(mailing address)

description of formations encountered	from	to
Red CLAY	0	8
GREY BUCKSHOT	8	20
LOIME ROCK + SHALE	20	50
BLUE SHALE	50	160
ROCK + SHALE	160	250

WELL LOCATION:  
sec. 29 T 9 S R. 2 E  
6 miles W of PONTOTOC  
(distance) (direction) (nearest town)

WELL PURPOSE: TENANT  
(home, irrigation, municipal, industrial)

WELL COMPLETION DATA:

(1) diameter (inches) 4

(2) total depth (feet) 250

(3) static water level (feet) 65 below top of ground.

(4) casing STEEL 79  
(material) (depth)  
4" if telescope see back.  
(size)

(5) screen \_\_\_\_\_  
(length) (depth, to top)  
(size) (material)


(6) pump NONE \_\_\_\_\_  
(HP) (yield gpm)  
(type power)

(7) electric log \_\_\_\_\_  
(yes or no)  
(organization running log)

(8) how well bottom plugged \_\_\_\_\_

PUMPING EQUIPMENT  
FURNISHED AND INSTALLED  
BY OWNER


# CODED

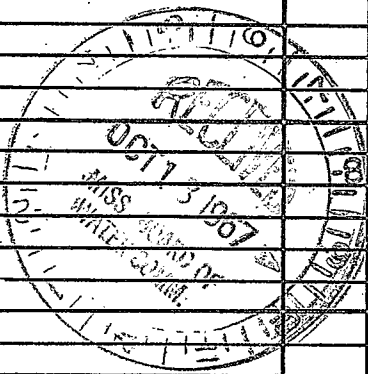

DRILLERS REMARKS:  
PUMP INSTALLED  
BY OTHERS

If well telescopes please sketch and show depths.

GROUND LEVEL

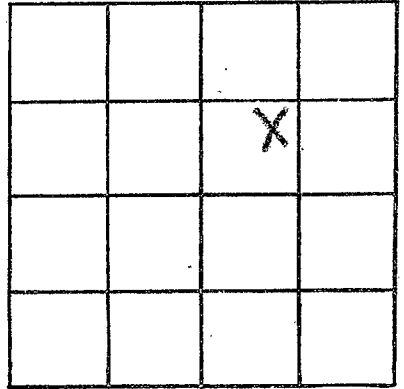

SECTION 28

Please indicate well location X.

ADDITIONAL INFORMATION

If more than one screen, show locations of each on sketch.