

CODED

CODED

Pontotoc
B-66
10-67

MISSISSIPPI
BOARD OF WATER COMMISSIONERS
416 North State Street
Jackson, Mississippi 39201

WATER WELL DRILLERS LOG

10-6-67 19 ~~7~~ LAMAR WILDER PONTOTOC
date well completed firm name county well located

LANDOWNER:

VITSLB EASTERLINS #1

RTS - PONTOTOC
(mailing address)

WELL LOCATION:

sec. 28 T. 9 R. 2 E
6 miles W of PONTOTOC
(distance) (direction) (nearest town)

WELL PURPOSE: HOME
(home, irrigation, municipal, industrial)

WELL COMPLETION DATA:


- (1) diameter (inches) 4
- (2) total depth (feet) 260
- (3) static water level (feet) 70 below above top of ground.
- (4) casing 4" steel - 34'
(material) (depth)
- _____ if telescope see back.
(size):
- (5) screen _____
(length) (depth to top)
- _____ (size) _____ (material)
- (6) pump 1/3 5
(HP) (yield gpm)
- ELECTRIC
(type power)
- (7) electric log _____
(yes or no)
- _____ (organization running log)
- (8) how well bottom plugged _____

description of fomations encountered

from to

GREY BUCKSHOT	0	25
LIME ROCK & SHALE	25	60
BLUE SHALE	60	150
ROCK & SAND	150	260


CODED

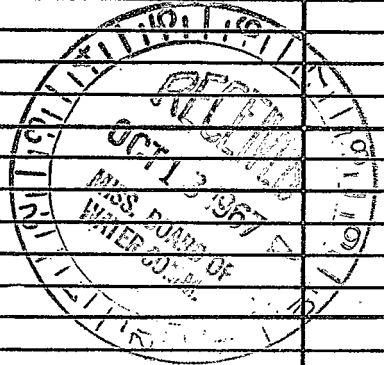

DRILLERS REMARKS:

If well telescopes please sketch and show depths.

GROUND LEVEL

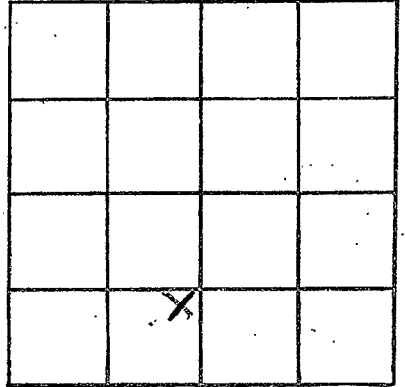

SECTION 28

Please indicate well location X.

ADDITIONAL INFORMATION

If more than one screen, show locations of each on sketch.