

CODED

Pontotoc
B-67
11-67

MISSISSIPPI
 BOARD OF WATER COMMISSIONERS
 416 North State Street
 Jackson, Mississippi 39201

WATER WELL DRILLERS LOG

11-20-67 19 LAMAR WILBER PONTOTOC

date well completed

firm name

county well located

LANDOWNER:

description of formations encountered

from

to

ROY NIBLETT

GREY BUCKSHOT
BLUE SHALE
ROCK & SAND

0 40
40 110
110 184

RT-2 PONTOTOC
 (mailing address)

WELL LOCATION:

sec. 26 T. 9 N. R. 2 E.
3 miles W of Pontotoc
 (distance) (direction) (nearest town)

WELL PURPOSE: HOME
 (home, irrigation, municipal, industrial)

WELL COMPLETION DATA:

- (1) diameter (inches) 4
 (2) total depth (feet) 184
 (3) static water level (feet) 72 below above top of ground.
 (4) casing STEEL, 90
 (material) (depth)
4" if telescope see back.
 (size)
 (5) screen _____
 (length) (depth to top)

CODED

- (size) (material)
 (6) pump 1/3 7
 (HP) (yield gpm)


ELECTRIC
 (type power)

- (7) electric log NO
 (yes or no)

 (organization running log)


- (8) how well bottom plugged _____

DRILLERS REMARKS:

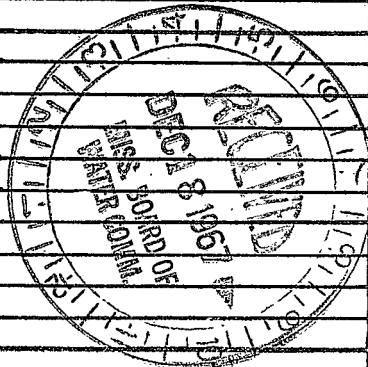

If well telescopes please sketch and show depths.

GROUND LEVEL

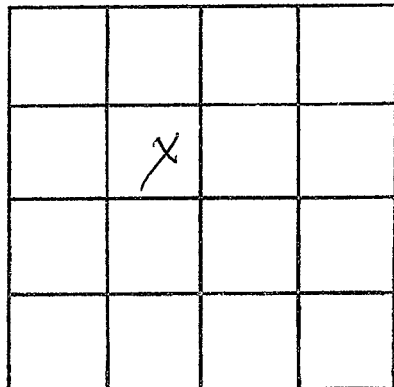

SECTION 26

Please indicate well location X.

ADDITIONAL INFORMATION

If more than one screen, show locations of each on sketch.